PLAN
SURVEYED
PLOTTED
ALIGNMENT CHECKED
RT. OF WAY CHECKED
NOTE BOOK
No.
BY

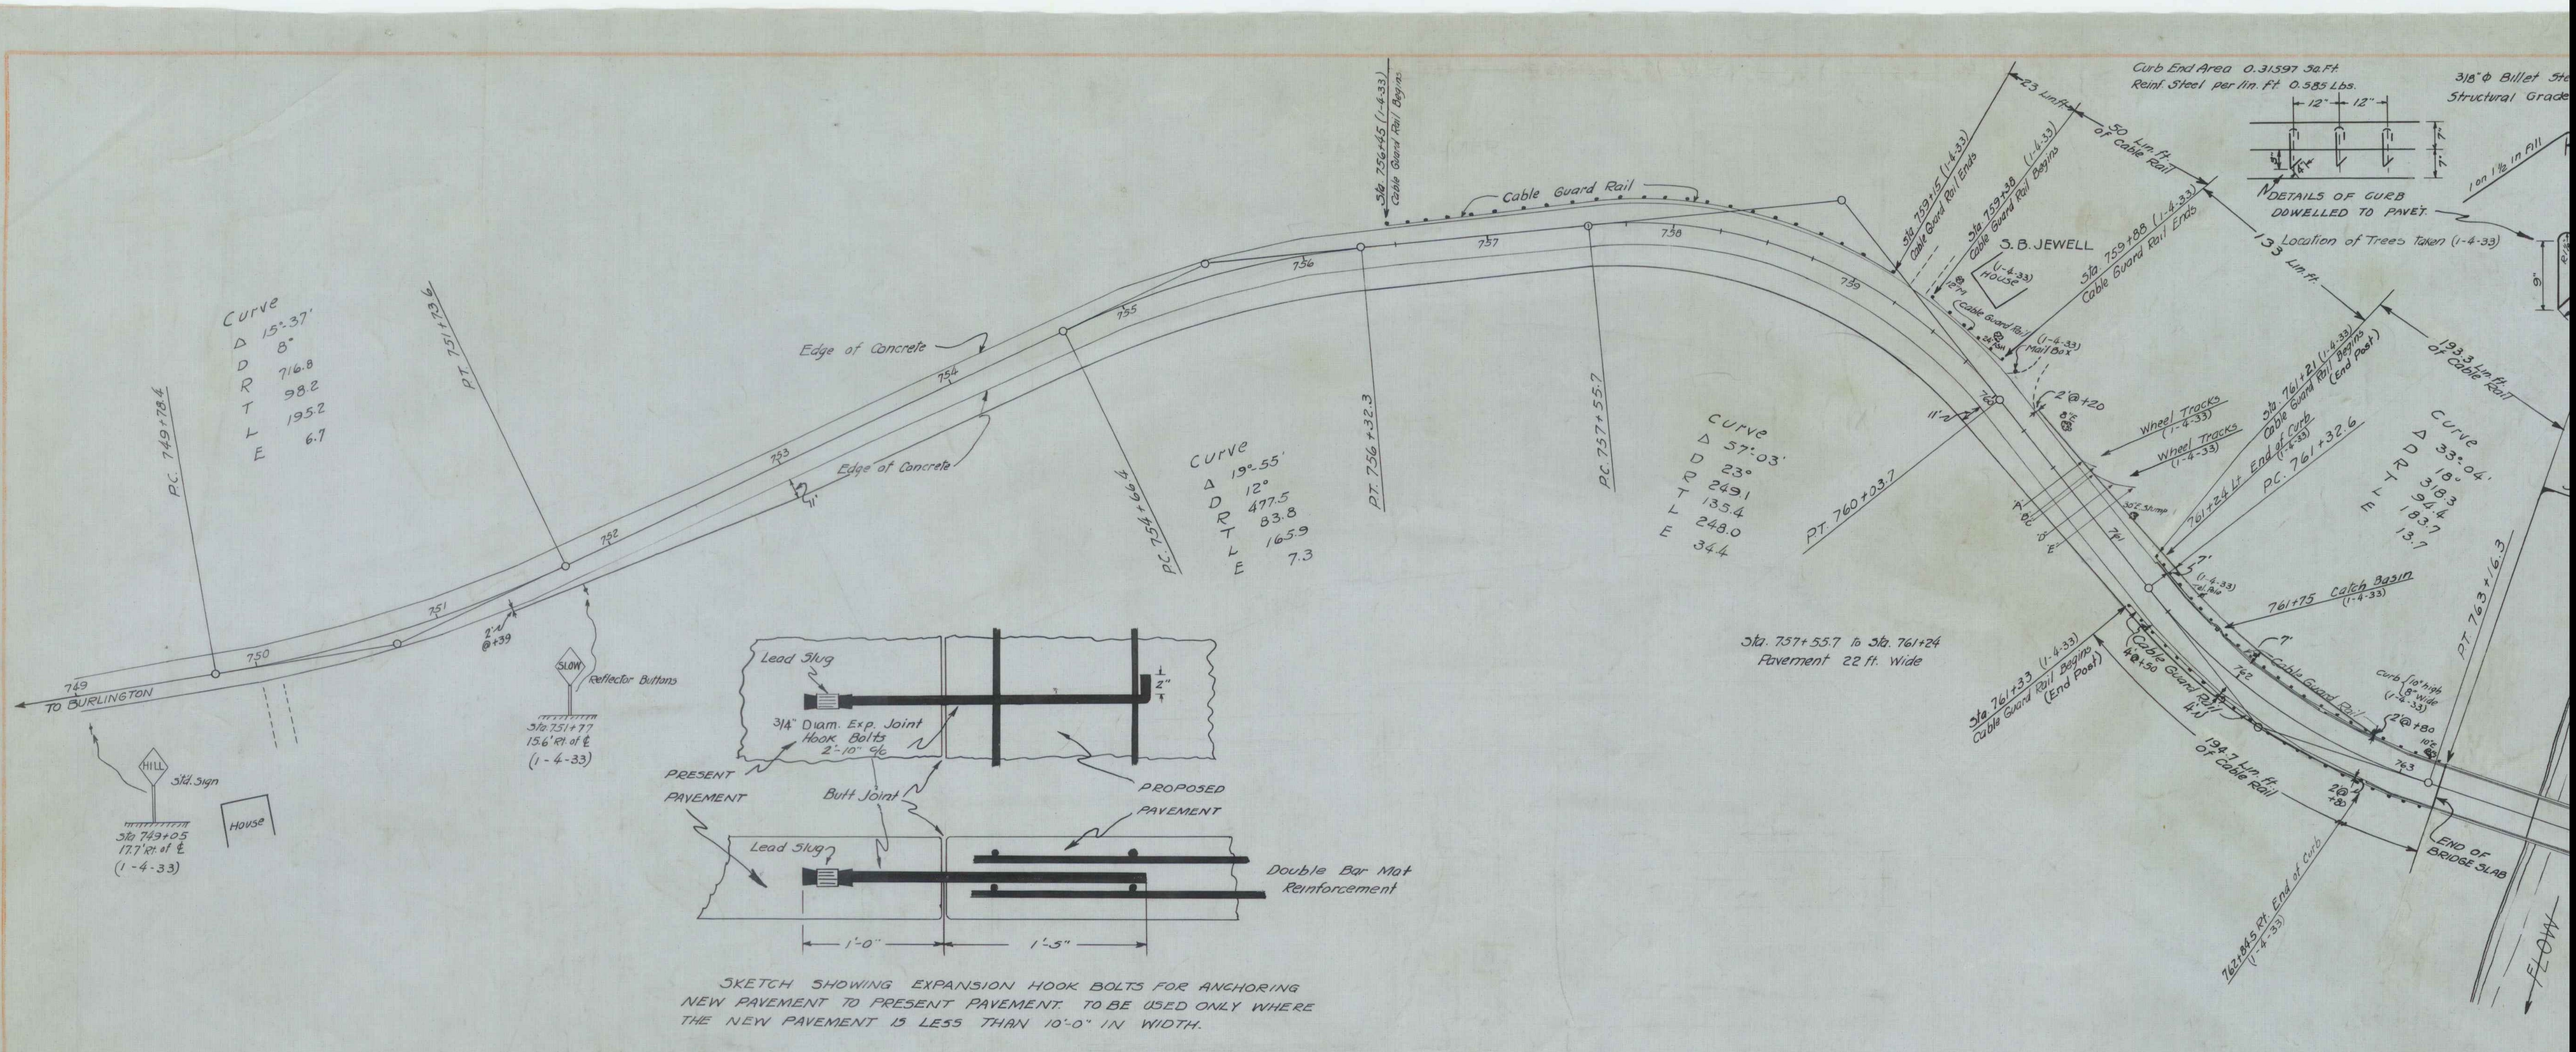
TO BURLINGTON
749
750
751
752
753
754
755
756
757
758
759
760
761
762
763
Curve
Δ 15°-37'
D 8°
R 716.8
T 98.2
L 195.2
E 6.7
P.C. 749+78.4
P.T. 751+73.6
HILL
Std. Sign
Sta. 749+05
17.7' Rt. of ℄
(1-4-33)
House
SLOW
Reflector Buttons
Sta. 751+77
15.6' Rt. of ℄
(1-4-33)
2'
@+39
Edge of Concrete
Edge of Concrete
11'
Curve
Δ 19°-55'
D 12°
R 477.5
T 83.8
L 165.9
E 7.3
P.C. 754+66.4
P.T. 756+32.3
P.C. 757+55.7
Sta. 756+45 (1-4-33)
Cable Guard Rail Begins
Cable Guard Rail
Curve
Δ 57°-03'
D 23°
R 249.1
T 135.4
L 248.0
E 34.4
P.T. 760+03.7
Sta. 759+15 (1-4-33)
Cable Guard Rail Ends
Sta. 759+38 (1-4-33)
Cable Guard Rail Begins
S.B. JEWELL
(1-4-33)
HOUSE
Cable Guard Rail
(1-4-33)
Mail Box
Sta. 759+88 (1-4-33)
Cable Guard Rail Ends
23 Lin. ft.
50 Lin. ft.
of Cable Rail
133 Lin. ft.
Location of Trees Taken (1-4-33)
11'
2'@+20
Wheel Tracks
(1-4-33)
Wheel Tracks
(1-4-33)
A
B
C
D
E
30" Stump
Sta. 757+55.7 to Sta. 761+24
Pavement 22 ft. Wide
Sta. 761+21 (1-4-33)
Cable Guard Rail Begins
(End Post)
761+24 Lt. End of Curb
(1-4-33)
P.C. 761+32.6
7'
(1-4-33)
Tel. Pole
761+75 Catch Basin
(1-4-33)
7'
Cable Guard Rail
Sta. 761+33 (1-4-33)
Cable Guard Rail Begins
(End Post)
Cable
4'@+50
Cable Guard Rail
4'
194.7 Lin. ft.
of Cable Rail
Curve
Δ 33°-04'
D 18°
R 318.3
T 94.4
L 183.7
E 13.7
193.3 Lin. ft.
of Cable Rail
PT. 763+16.3
Curb {10" high
8" wide
(1-4-33)
2'@+80
2'@
+80
END OF
BRIDGE SLAB
762+84.5 Rt. End of Curb
(1-4-33)
FLOW
Curb End Area 0.31597 Sq. Ft.
Reinf. Steel per lin. Ft. 0.585 Lbs.
12"
12"
7"
7"
3"
4"
DETAILS OF CURB
DOWELLED TO PAVE'T.
3/8" Φ Billet Ste
Structural Grade
1 on 1½ in All
9"
Lead Slug
3/4" Diam. Exp. Joint
Hook Bolts
2'-10" c/c
2"
PRESENT
PAVEMENT
Butt Joint
PROPOSED
PAVEMENT
Lead Slug
Double Bar Mat
Reinforcement
1'-0"
1'-5"

SKETCH SHOWING EXPANSION HOOK BOLTS FOR ANCHORING NEW PAVEMENT TO PRESENT PAVEMENT. TO BE USED ONLY WHERE THE NEW PAVEMENT IS LESS THAN 10'-0" IN WIDTH.

[redacted]

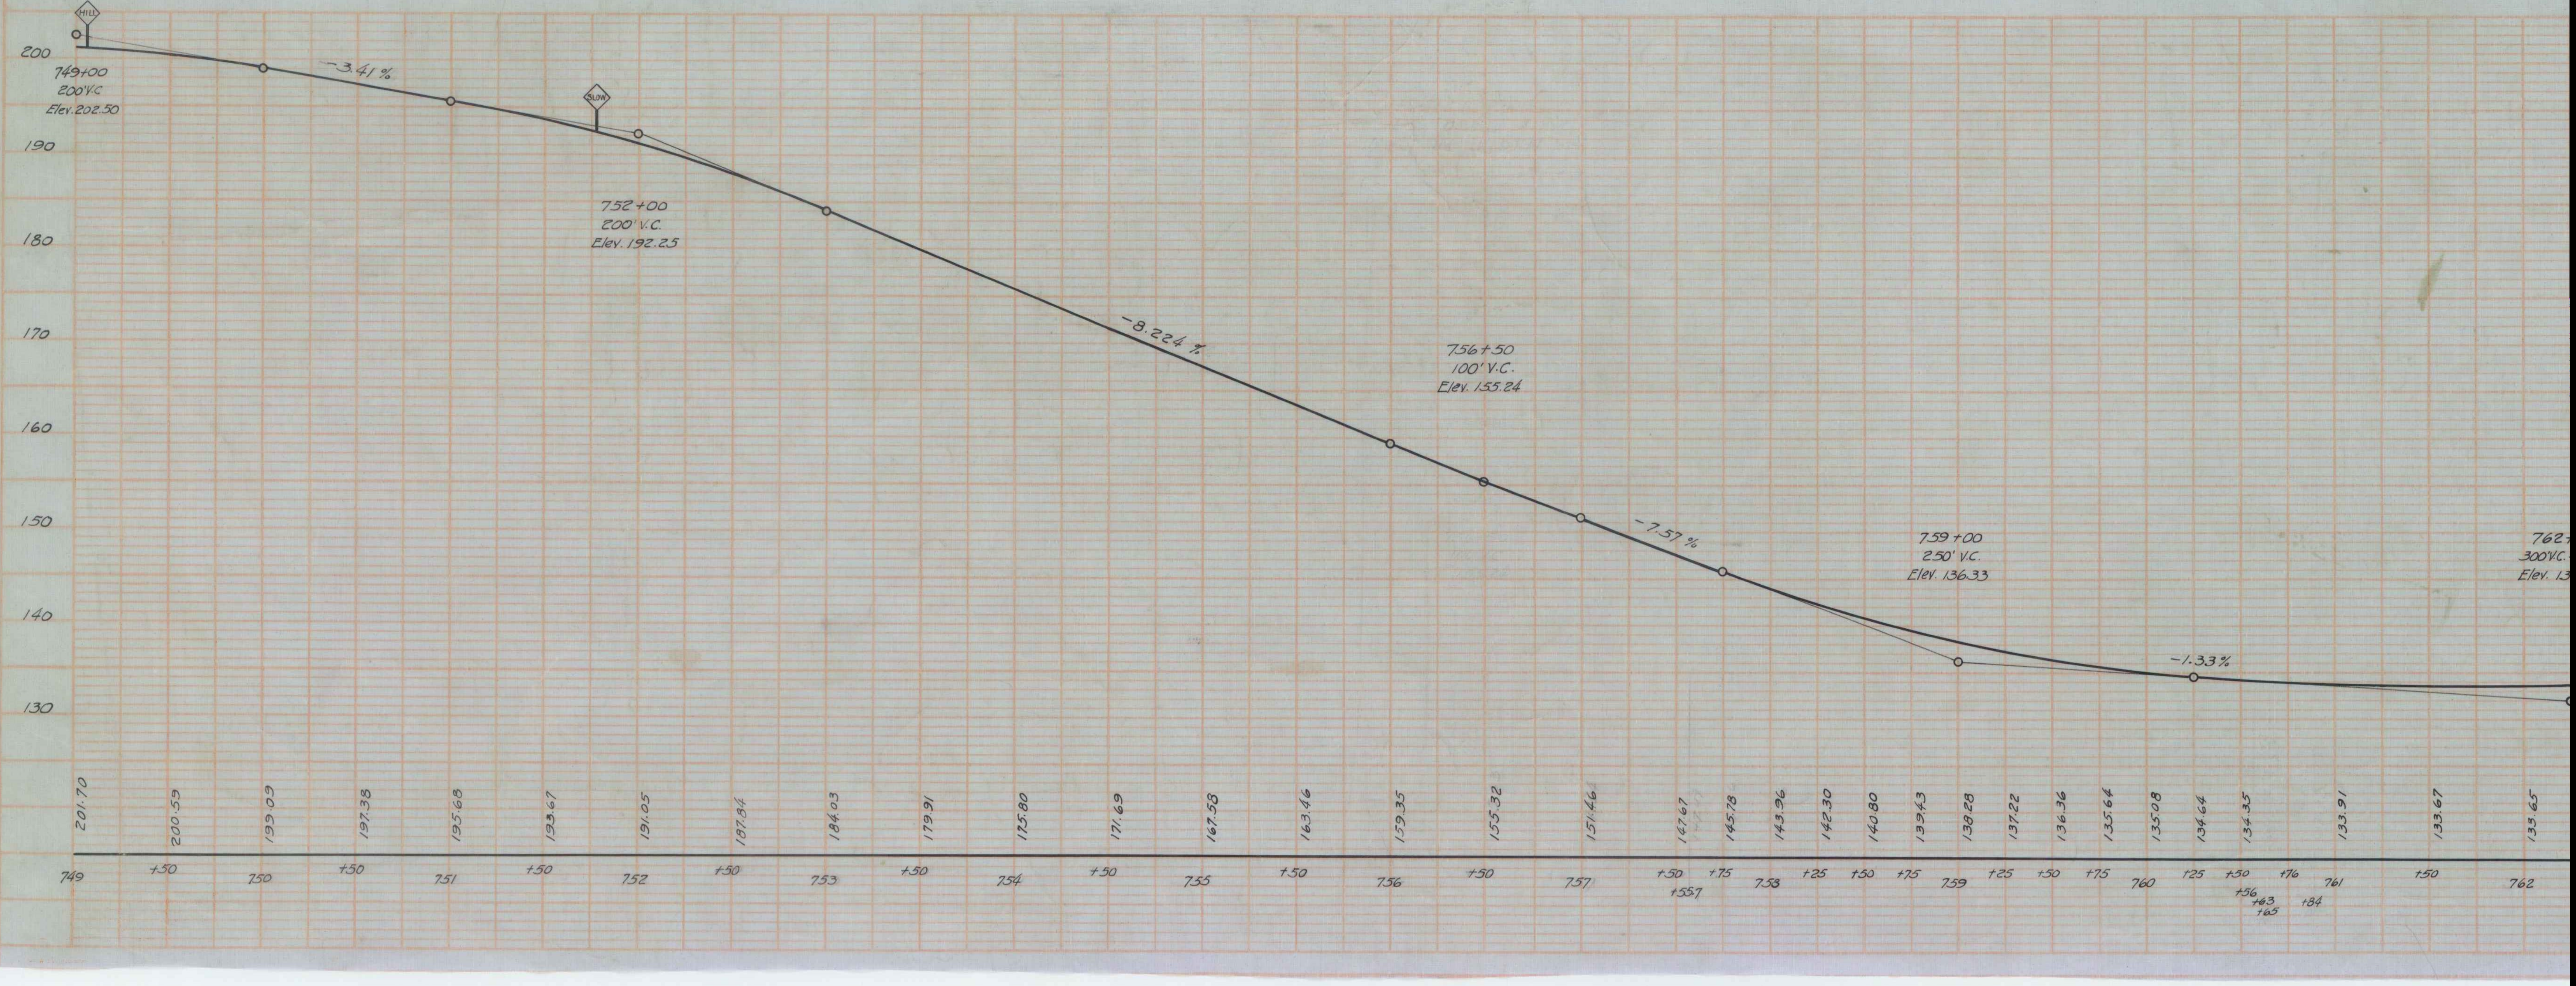PROFILE
SURVEYED
PLOTTED
GRADES CHECKED
R.W. & NOTES
STRUCTURE NOTATIONS
NOTE BOOK
No.
DATE
BY