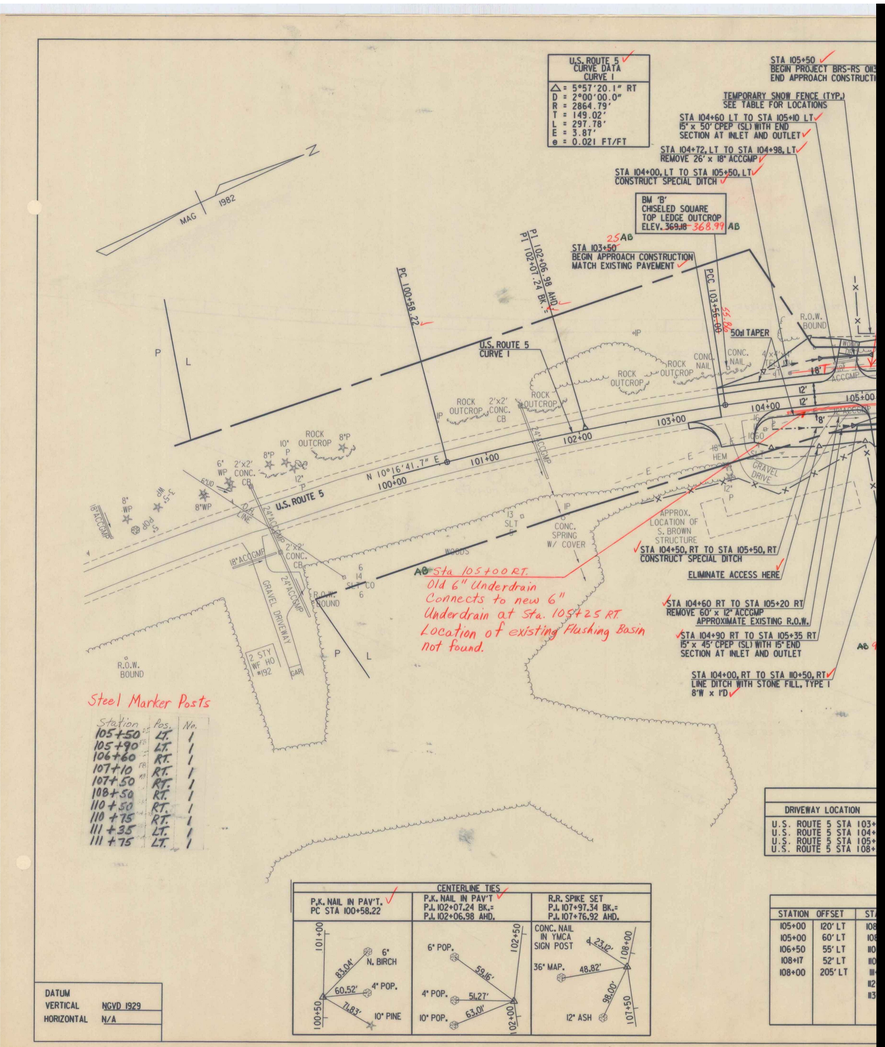

Steel Marker Posts

Station	Pos.	No.
105+50	LT.	1
105+90	LT.	1
106+60	RT.	1
107+10	RT.	1
107+50	RT.	1
108+50	RT.	1
110+50	RT.	1
110+75	RT.	1
111+35	LT.	1
111+75	LT.	1

DRIVEWAY LOCATION
U.S. ROUTE 5 STA 103+
U.S. ROUTE 5 STA 104+
U.S. ROUTE 5 STA 105+
U.S. ROUTE 5 STA 108+

CENTERLINE TIES		
P.K. NAIL IN PAV'T. PC STA 100+58.22	P.K. NAIL IN PAV'T P.J. 102+07.24 BK.= P.J. 102+06.98 AHD.	R.R. SPIKE SET P.J. 107+97.34 BK.= P.J. 107+76.92 AHD.
6" N. BIRCH, 4" POP., 10" PINE, 83.04', 60.52', 71.83', 101+00, 100+50	6" POP., 4" POP., 10" POP., 59.16', 51.27', 63.01', 102+50, 102+00	CONC. NAIL IN YMCA SIGN POST, 36" MAP., 12" ASH, 23.12', 48.82', 98.00', 108+00, 107+50

STATION	OFFSET	STA
105+00	120' LT	108
105+00	60' LT	108
106+50	55' LT	110
108+17	52' LT	110
108+00	205' LT	111
		112
		113

DATUM	
VERTICAL	NGVD 1929
HORIZONTAL	N/A