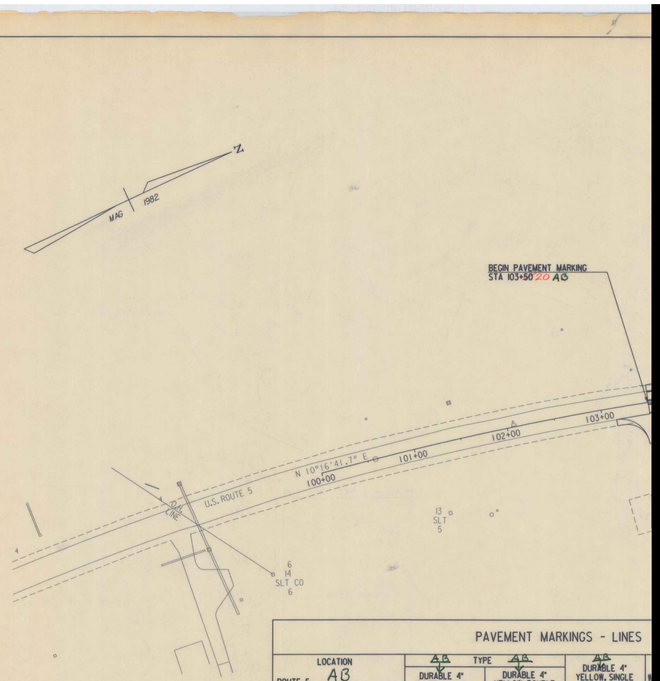

PAVEMENT MARKINGS - LINES

LOCATION ROUTE 5 (AB)	TYPE (AB) DURABLE 4" WHITE, SINGLE	DURABLE 4" YELLOW, DOUBLE	(AB) DURABLE 4" YELLOW, SINGLE	W
U.S. RTE 5				
STA 103+50 TO 120+40 LT	1715 1660 LF			
STA 103+50 TO 120+30 RT	1701 1680 LF			
STA 103+50 TO 120+35 ℄		1700 1685 LF		
STA 121+20 TO 122+35 RT VT II 1450	120 LF			
STA 121+30 TO 122+40 LT VT II 1280	160 LF			
STA 121+30 TO 122+35 ℄		115 105 LF		
STA 122+35 RT		1815 7630		
SUBTOTAL	4085 3620 LF	1790 X 2 = 3580		
SERVICE DRIVE				
STA 0+15 LT				
STA 0+15 TO 0+30 ℄		37 55 LF		
STA 1+00 TO 3+01 ℄		98 201 LF		
SUBTOTAL		135 256 X 2 = 512 270		
U.S. RTE 5/VERMONT RTE II				
STA 12+90 TO 14+10 (MEDIAN)		300 265 LF		
STA 12+90 TO 14+10 LT	148 120 LF			
STA 12+90 TO 14+10 RT				
STA 12+90 TO 13+35 RT	45 LF			
STA 14+90 TO 16+25 RT			230 135 LF	
STA 14+90 TO 18+55 LT			370 365 LF	
STA 14+45 TO 16+25 RT	190 LF			
STA 14+95 TO 18+55 LT	357 370 LF			
STA 14+90 TO 16+55 LT	165 LF			
STA 14+90 TO 18+55 LT				
STA 16+55 TO 18+55 LT		300 600		
SUBTOTAL	670 890 LF	255 X 2 = 510	626 500 LF	
TOTAL	4755 4510 LF	4500 4602 LF	626 500 LF	

LEGEND

(R) REMOVE
(N) NEW
(S) SALVAGE

DATUM	
VERTICAL	NGVD 1929
HORIZONTAL	N/A