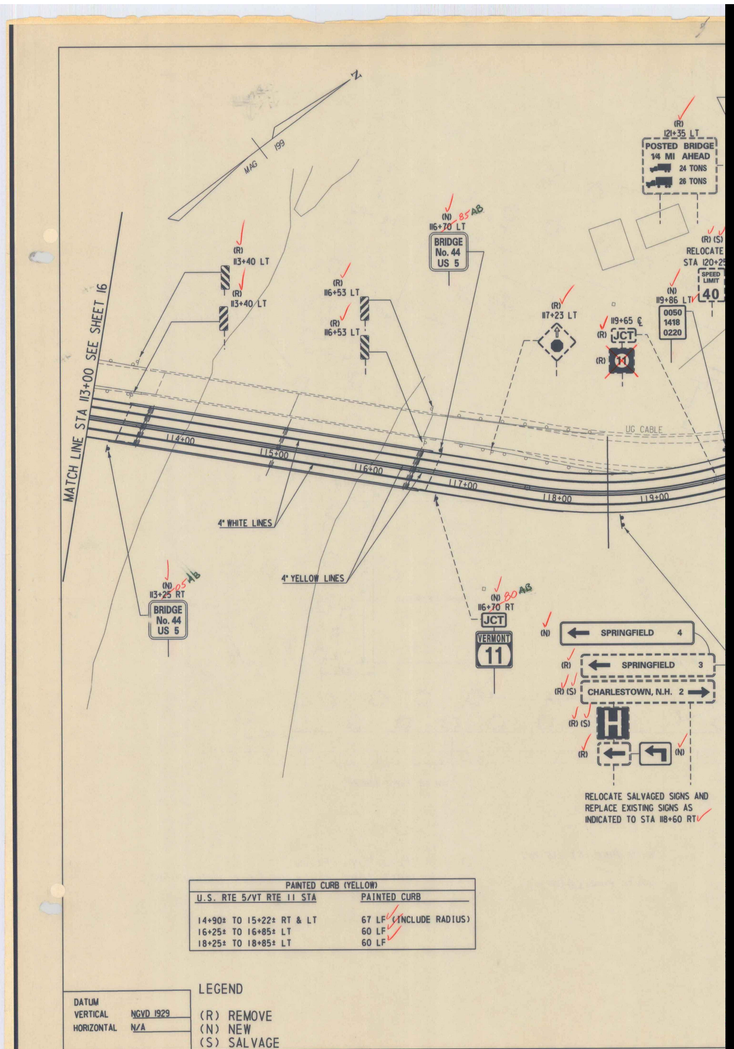

PAINTED CURB (YELLOW)	
U.S. RTE 5/VT RTE 11 STA	PAINTED CURB
14+90± TO 15+22± RT & LT	67 LF (INCLUDE RADIUS)
16+25± TO 16+85± LT	60 LF
18+25± TO 18+85± LT	60 LF

DATUM	
VERTICAL	NGVD 1929
HORIZONTAL	N/A

LEGEND

(R) REMOVE
(N) NEW
(S) SALVAGE