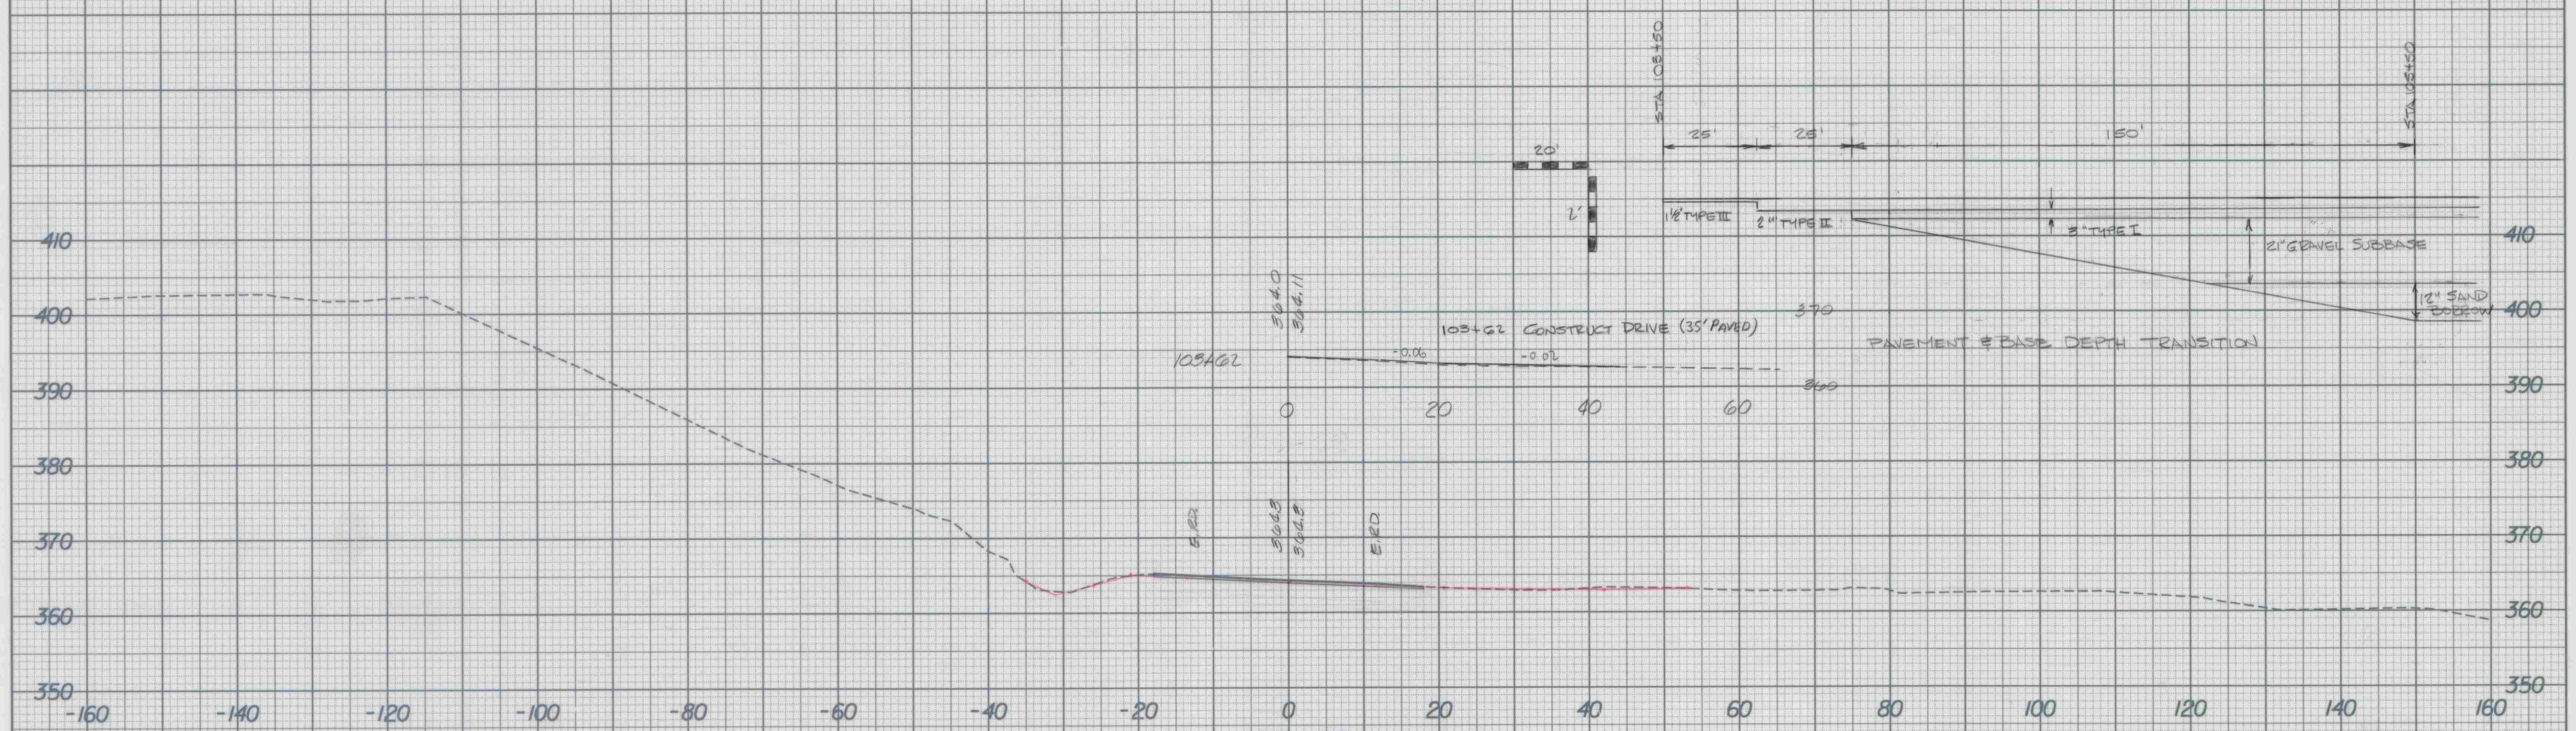

103+50

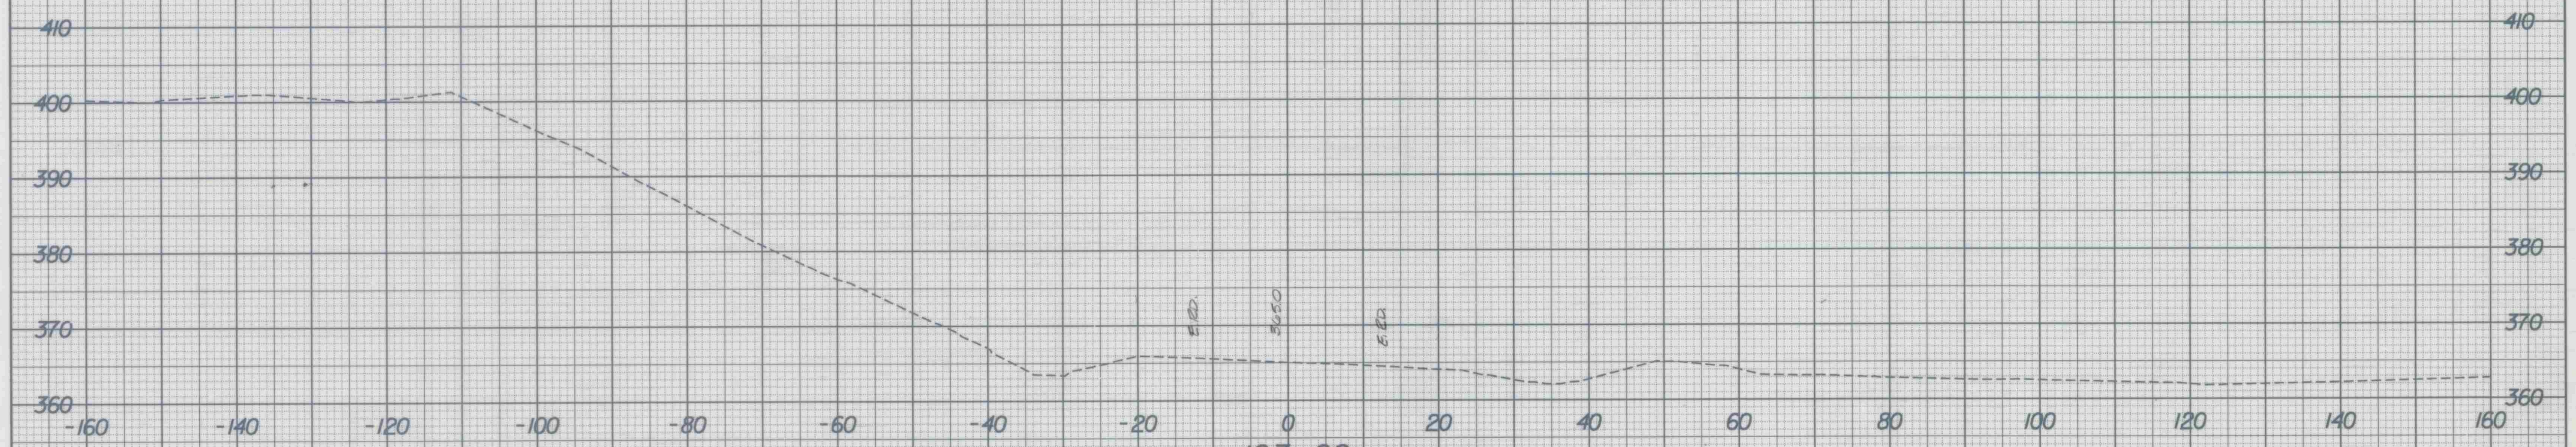

103+00

SCALE 10 FEET

FROM STA. 103+00 TO STA. 103+50 U.S. ROUTE 5
PROJECT NAME: SPRINGFIELD BRIDGE REPLACEMENT
PROJECT NO. BRS-RS 0113(8)
PLOTTED BY: CJM 8/23/93 CHECKED BY: JRM 8/25/93
SHEET 64 OF 90 SHEETS