 
370
360
350
340
330
-160
-140
-120
-100
-80
-60
-40
370
360
350
340
330
-160
-140
-120
-100
-80
-60
-40
370
360
350
340
-160
-140
-120
-100
-80
-60
-40