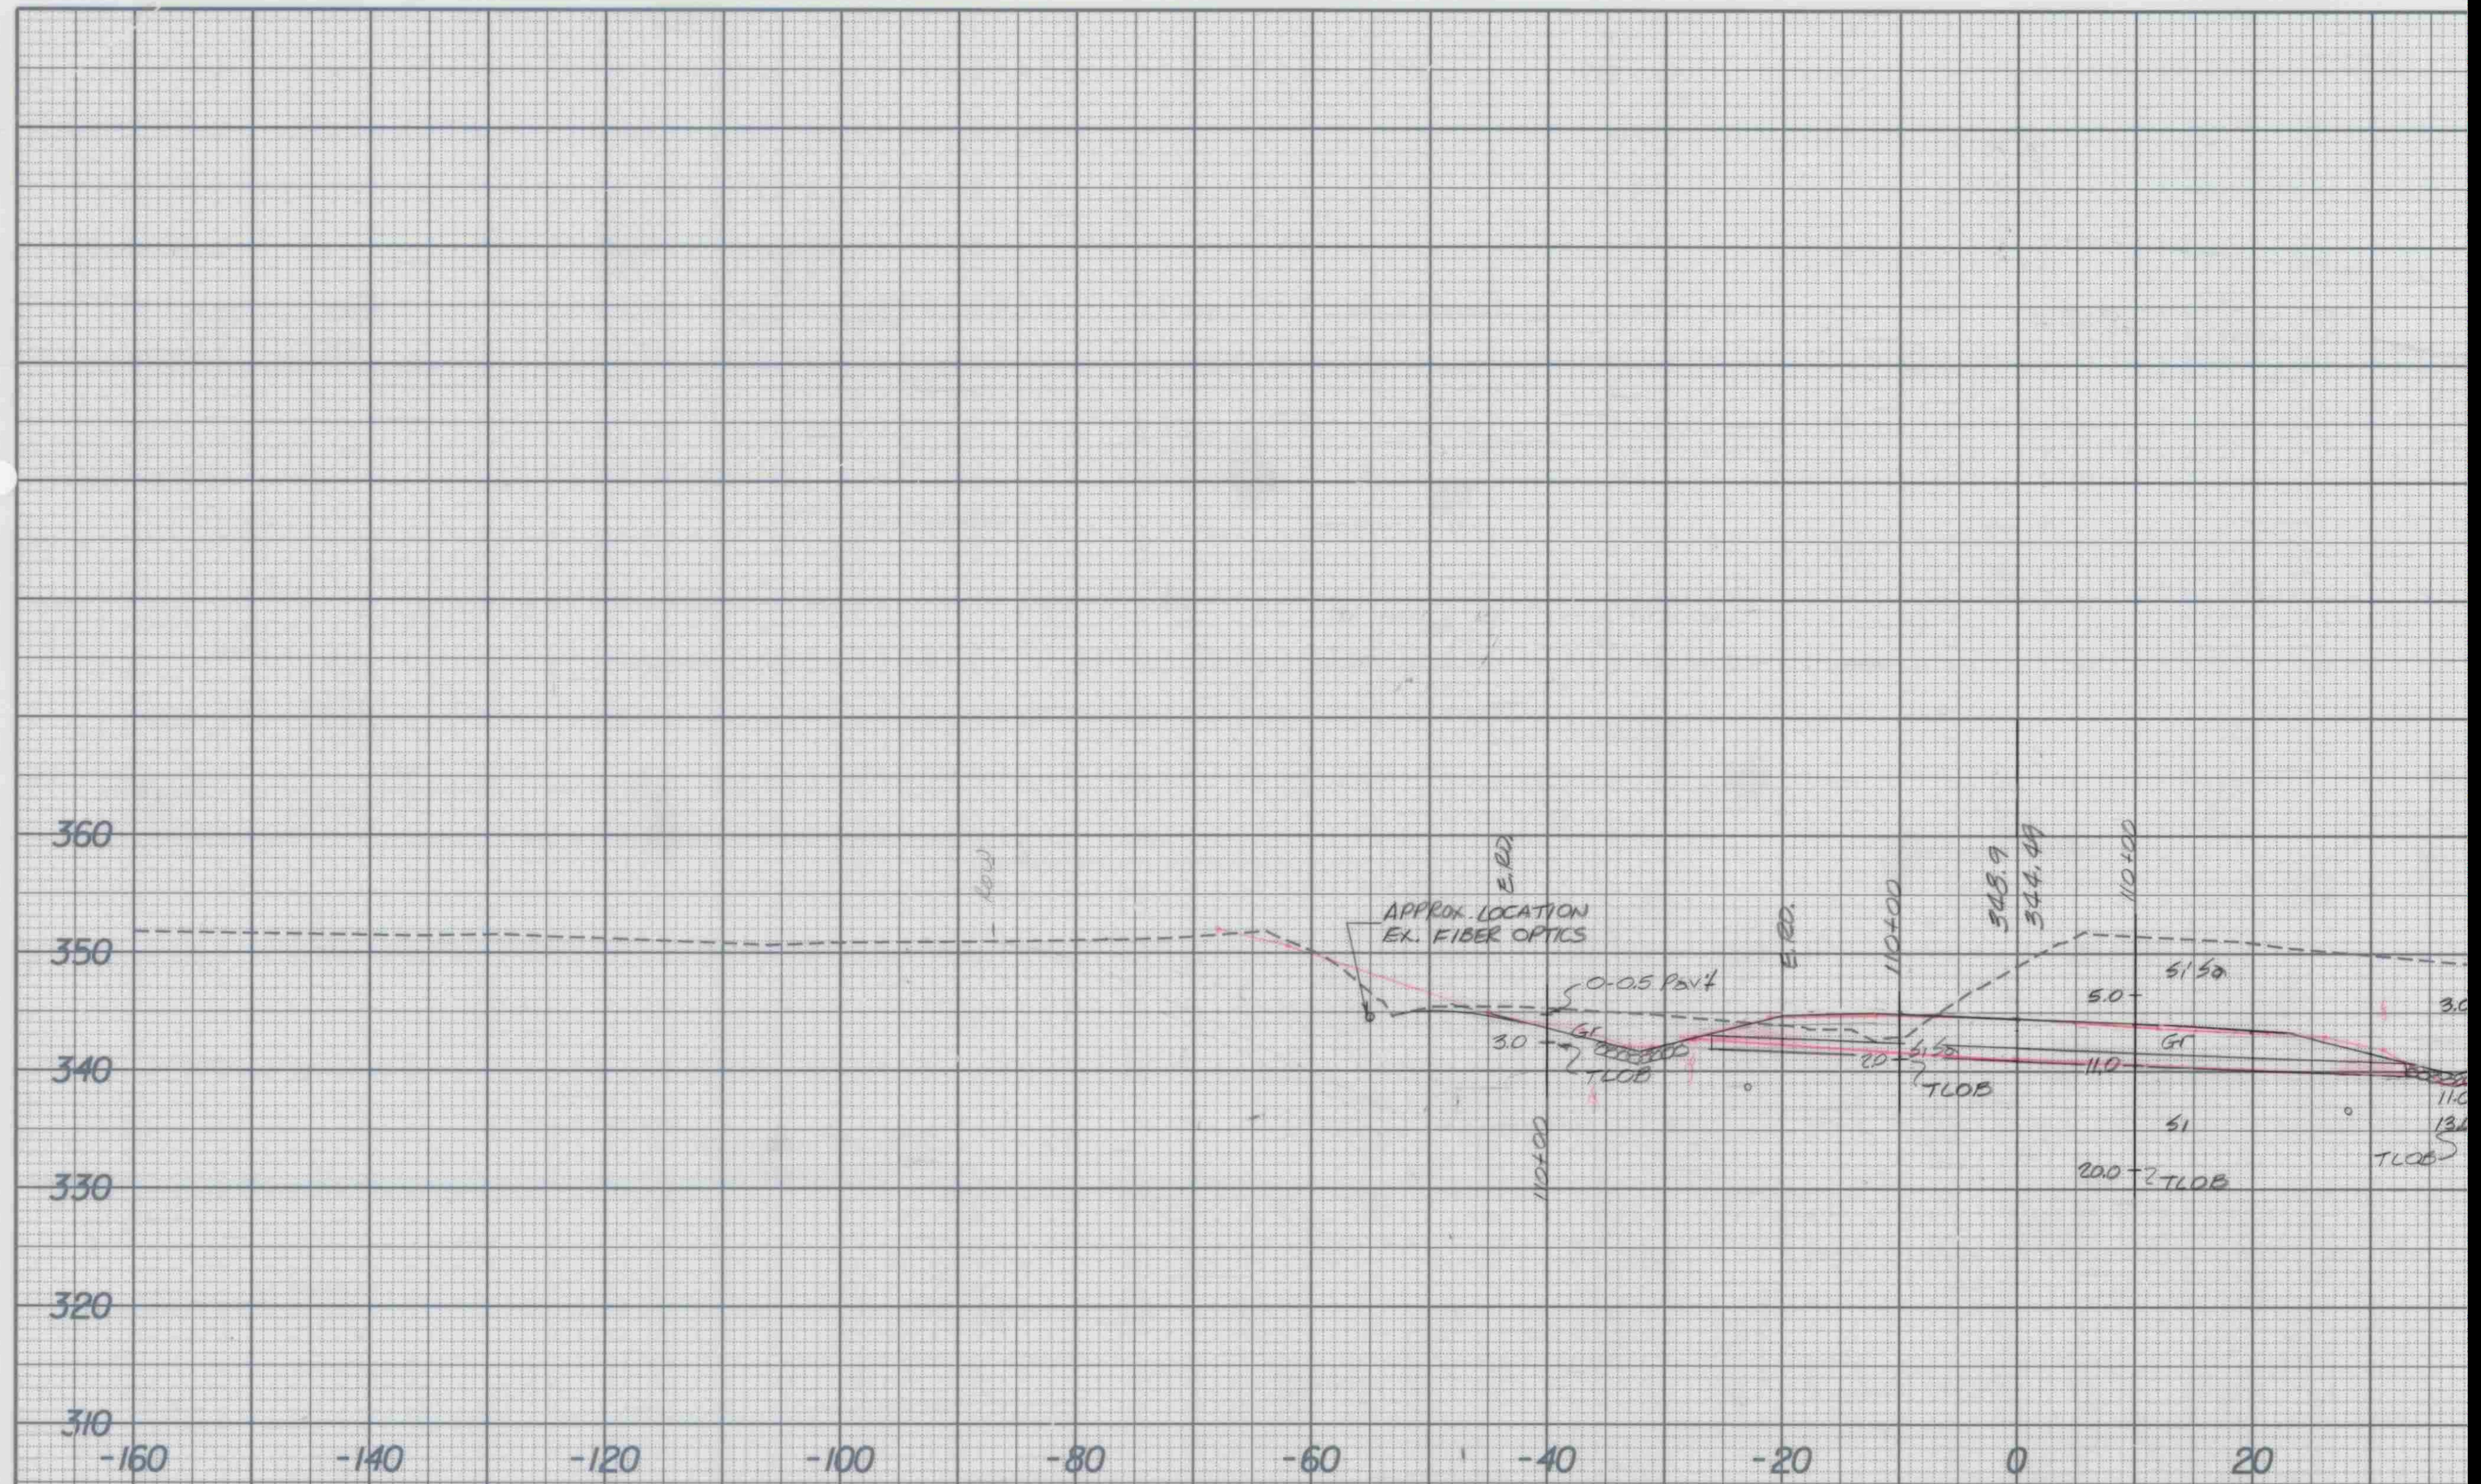
360
350
340
330
320
310
-160
-140
-120
-100
-80
-60
-40
-20
0
20
ROW
APPROX. LOCATION
EX. FIBER OPTICS
E.RD.
0-0.5 Pav't
3.0
Gr
TLOB
110+00
E.RD.
110+00
20
6'/50
TLOB
348.9
344.49
110+00
6'/50
5.0
Gr
11.0
Sl
20.0
TLOB
3.0
11.0
13
TLOB

110+00

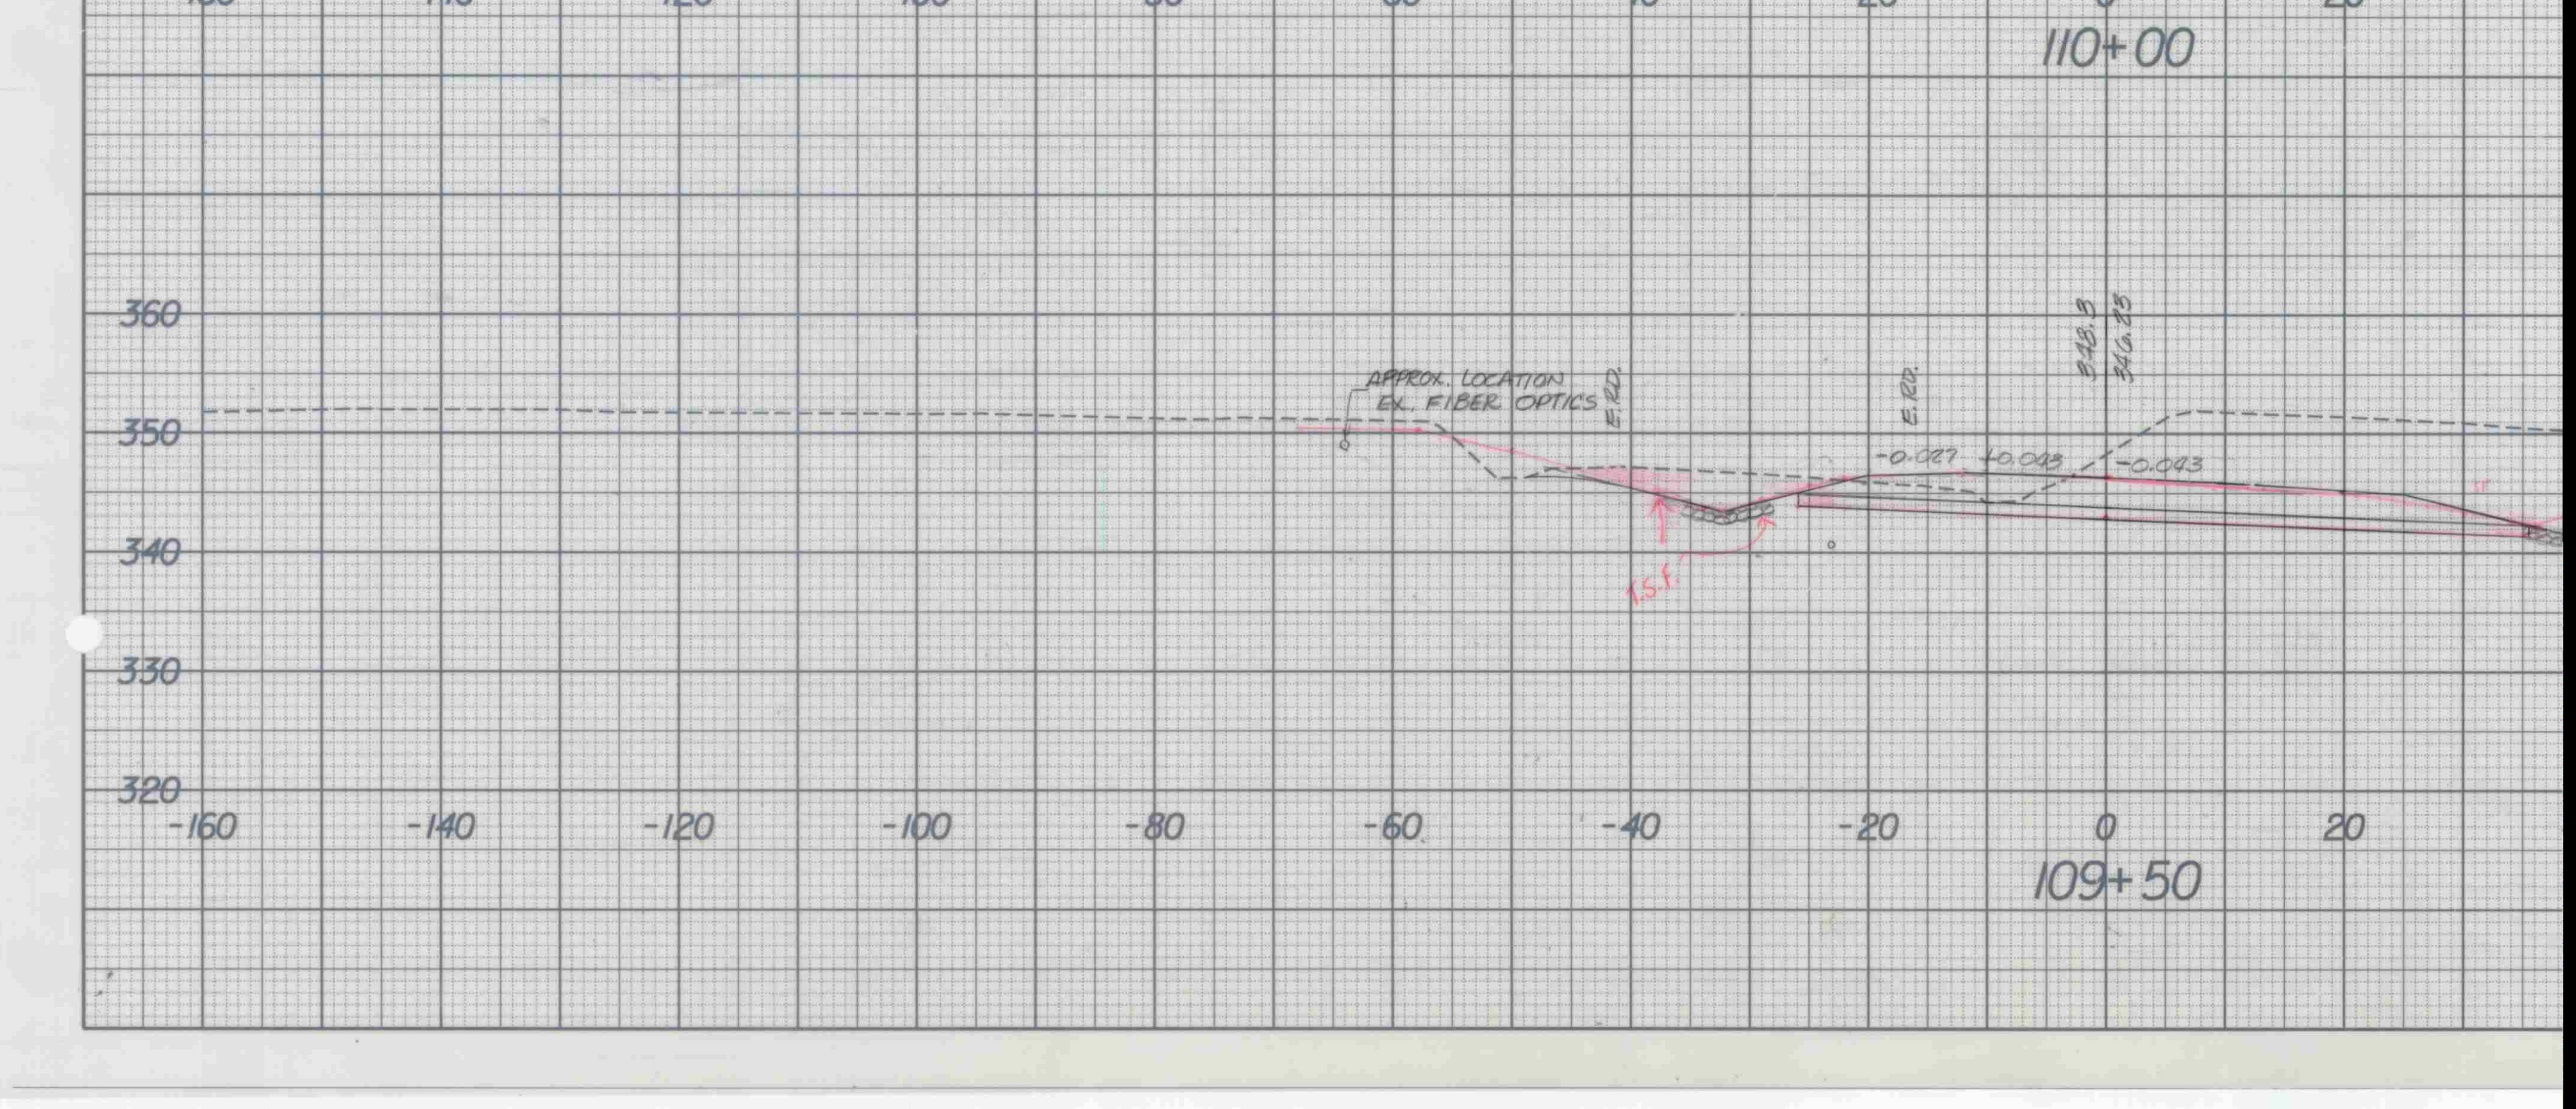
360
350
340
330
320
-160
-140
-120
-100
-80
-60
-40
-20
0
20
APPROX. LOCATION
EX. FIBER OPTICS
E.RD.
E.RD.
-0.027
+0.093
-0.043
348.3
346.23
T.S.F.

109+50

[redacted]