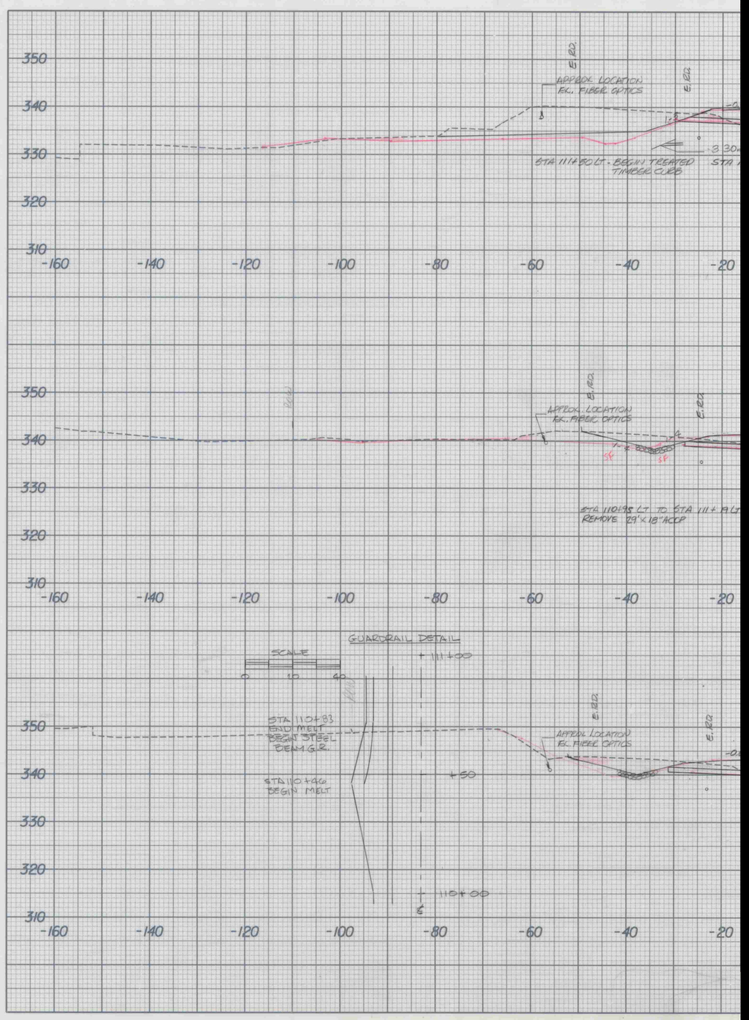
350
340
330
320
310
-160
-140
-120
-100
-80
-60
-40
-20
E 822
APPROX. LOCATION EL. FIBER OPTICS
STA 111+80 LT. BEGIN TREATED TIMBER CURB
STA 110+98 LT. TO STA 111+19 LT
REMOVE 23"x18" RCCP
GUARDRAIL DETAIL
SCALE
0
10
40
+111+00
+50
+110+00
STA 110+93
END MELT
BEGIN STEEL
DEMO GR.
STA 110+49
BEGIN MELT