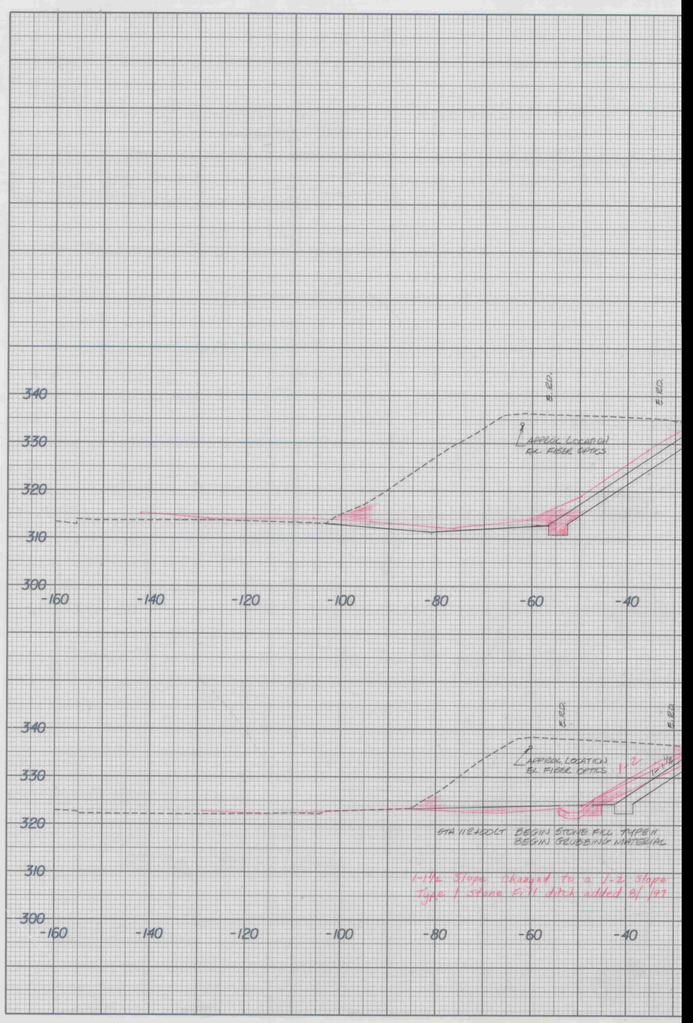

340
330
320
310
300
-160
-140
-120
-100
-80
-60
-40
E.R.D.
E.R.D.
APPROX. LOCATION
EX. FIBER OPTICS
340
330
320
310
300
-160
-140
-120
-100
-80
-60
-40
E.R.D.
E.R.D.
APPROX. LOCATION
EX. FIBER OPTICS
1-2
1-1½
STA 112+00 LT BEGIN STONE FILL TYPE II
BEGIN GRUBBING MATERIAL
1-1½ Slope changed to a 1-2 Slope
Type 1 Stone Fill ditch added 8/ 197