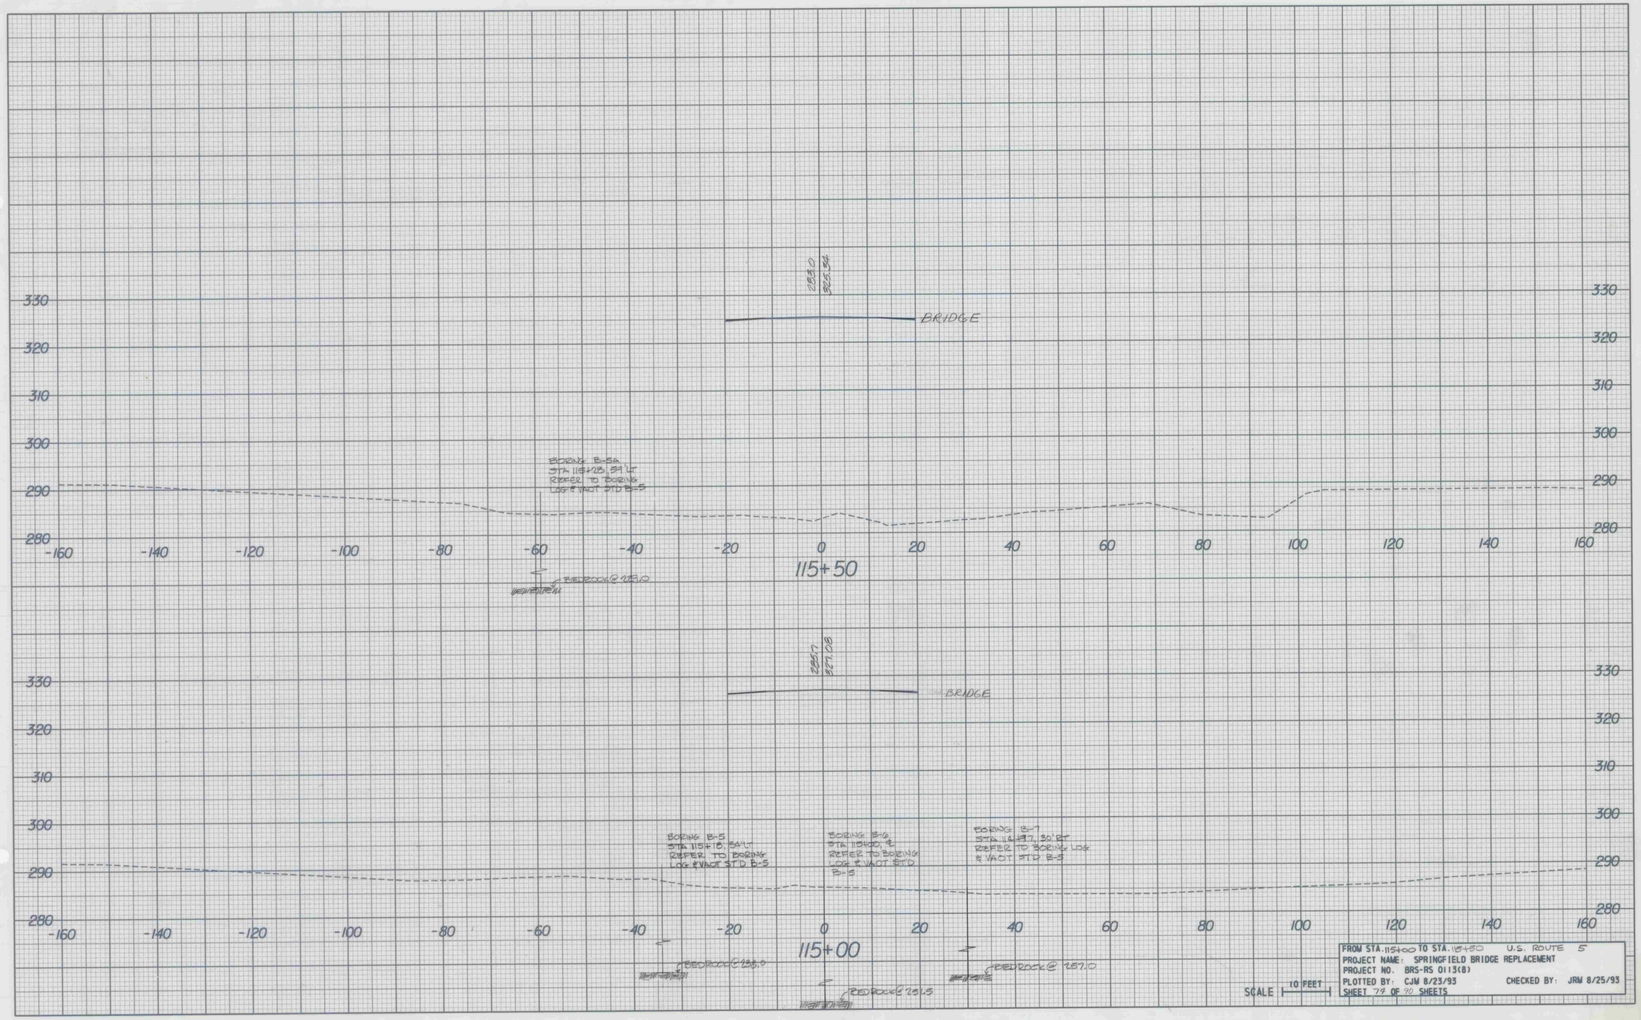
BRIDGE
BRIDGE
BORING B-5A
STA 115+10.59 LT
REFER TO BORING
BORING B-5
STA 115+18.54 LT
REFER TO BORING
BORING B-6
STA 115+00.8
REFER TO BORING
B-5
BORING B-7
STA 114+97.30 RT
REFER TO BORING LOG
115+50
115+00
SCALE 10 FEET
FROM STA. 115+00 TO STA. 116+50 U.S. ROUTE 5
PROJECT NAME: SPRINGFIELD BRIDGE REPLACEMENT
PROJECT NO. BRS-RS 0113(8)
PLOTTED BY: CJW 8/23/93 CHECKED BY: JRW 8/25/93
SHEET 79 OF 90 SHEETS