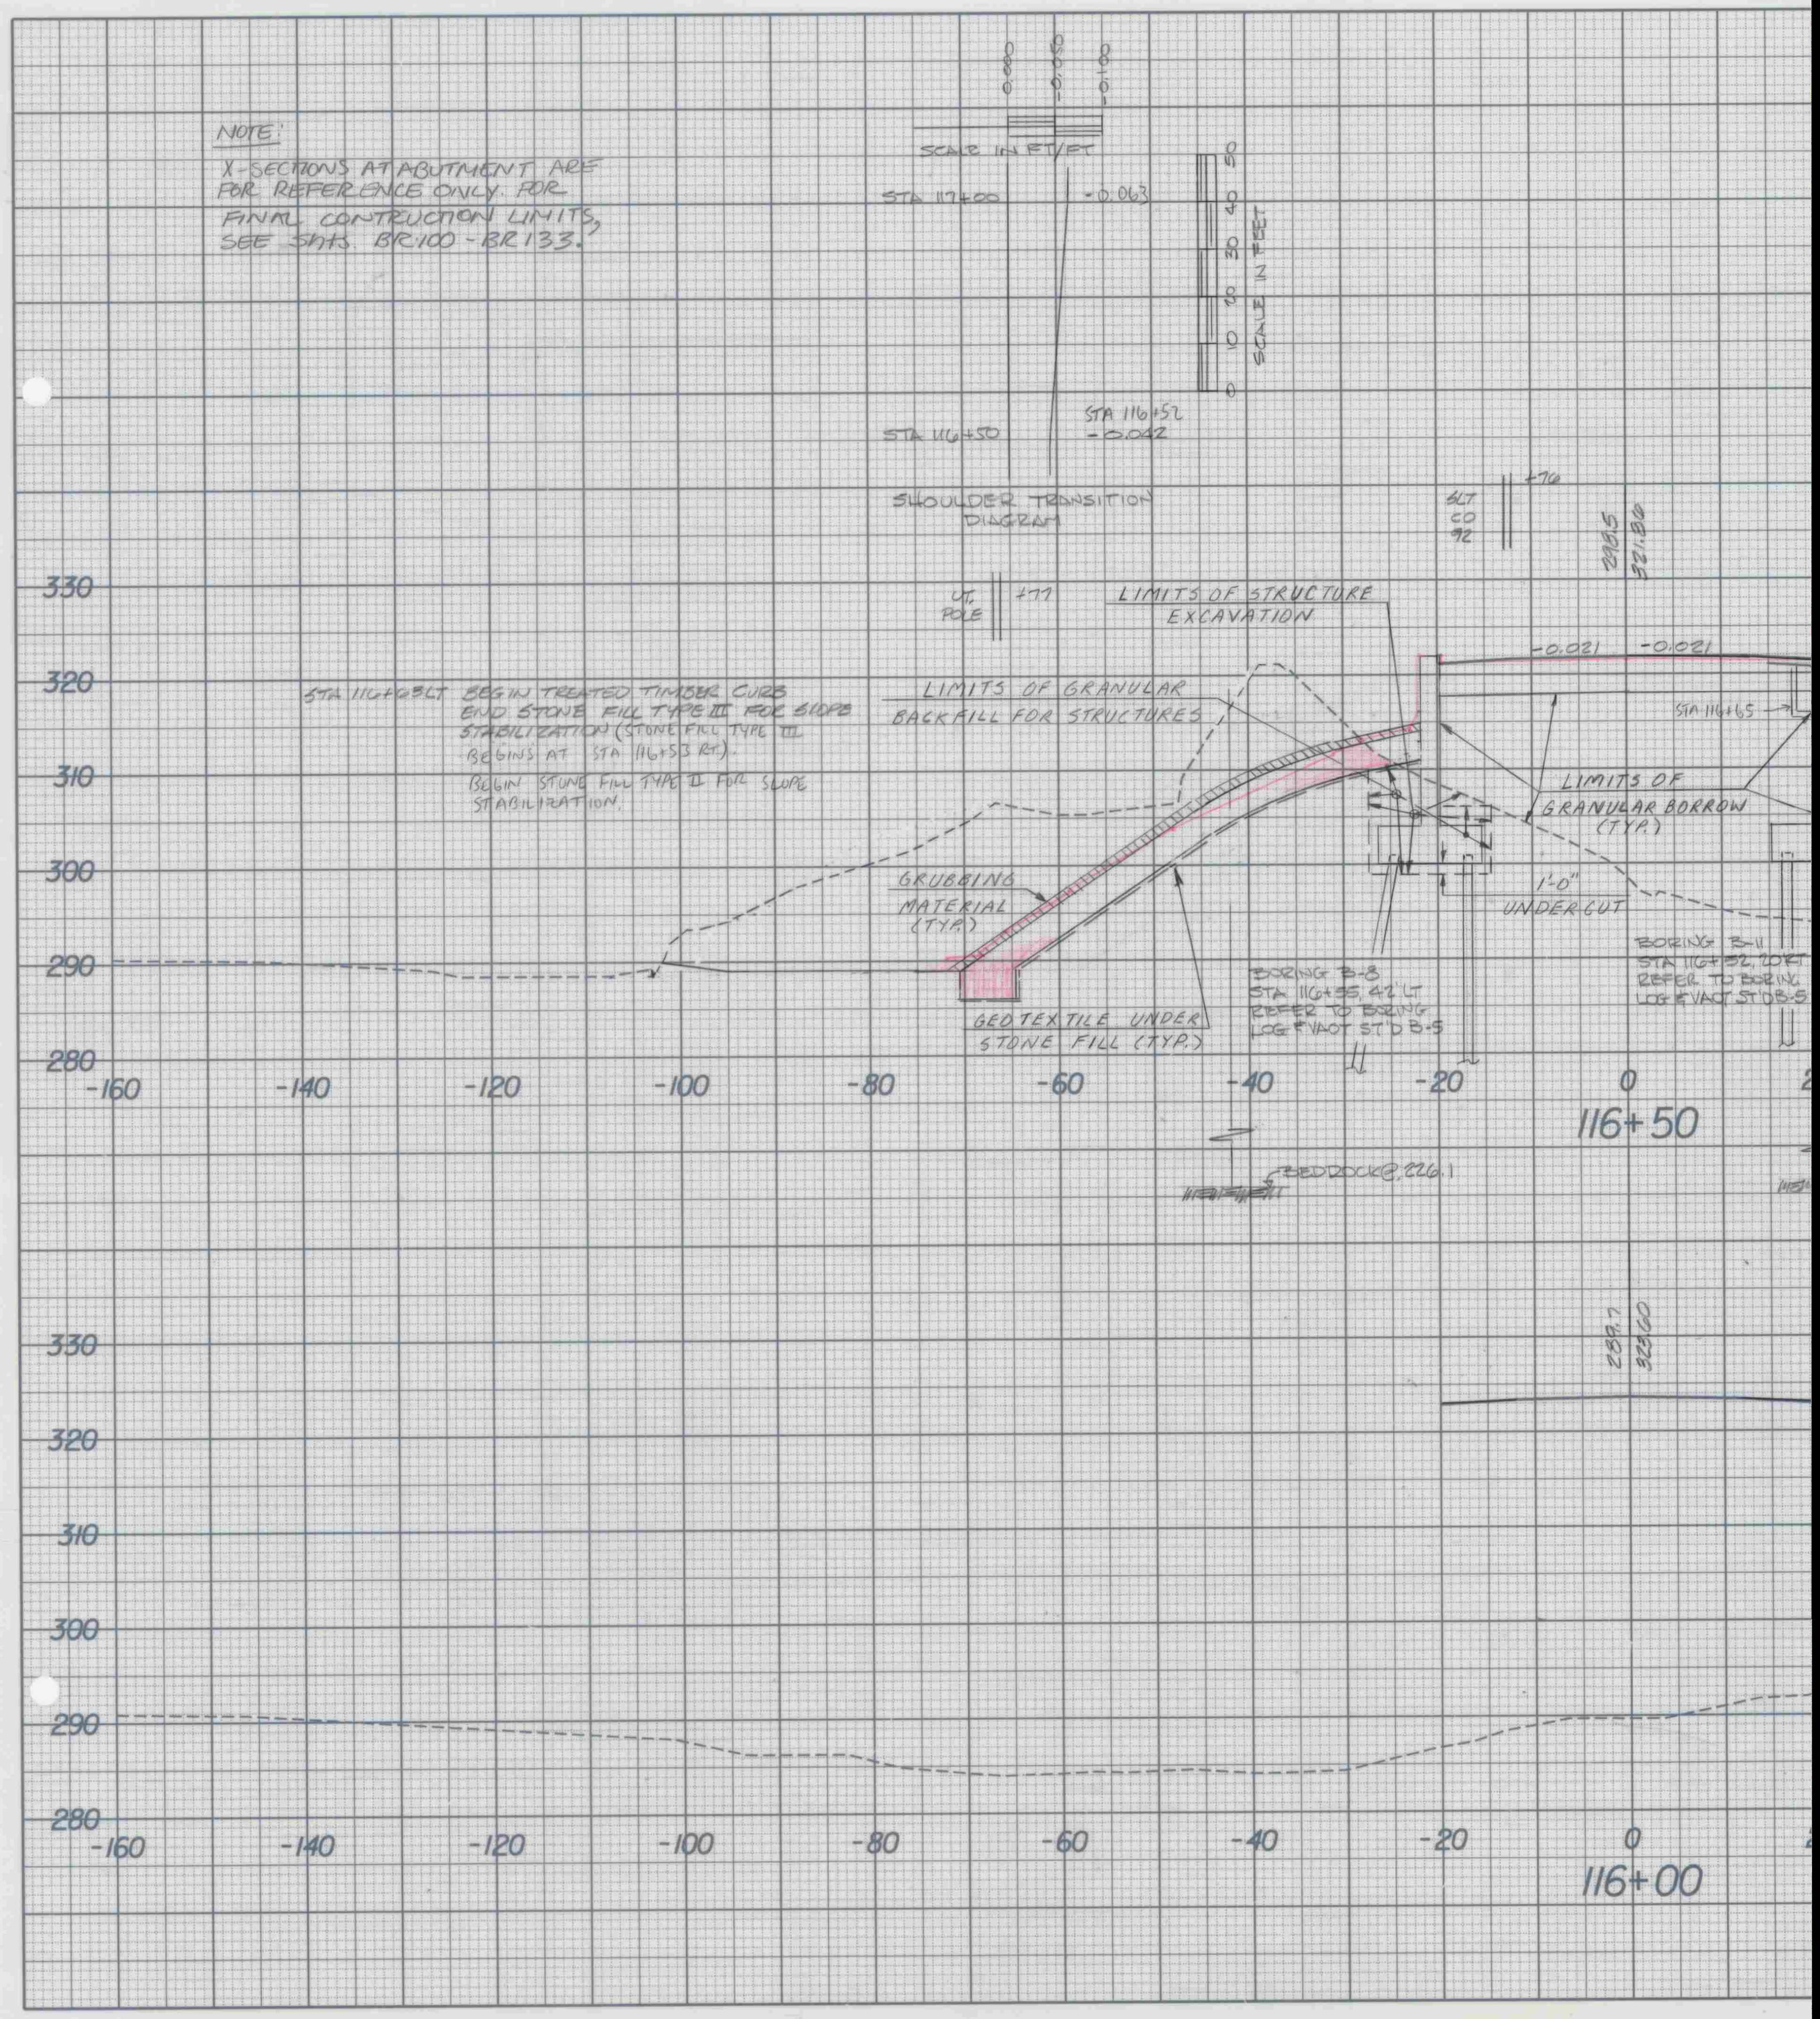
NOTE:
X-SECTIONS AT ABUTMENT ARE FOR REFERENCE ONLY. FOR FINAL CONTRUCTION LIMITS, SEE SHTS. BR100 - BR133.
0.00
-0.050
-0.100
SCALE IN FT/FT
STA 117+00
-0.063
STA 116+50
STA 116+52
-0.042
0
10
20
30
40
50
SCALE IN FEET
SHOULDER TRANSITION DIAGRAM
SLT CO 92
+76
298.5
321.80
UT. POLE
+77
LIMITS OF STRUCTURE EXCAVATION
LIMITS OF GRANULAR BACKFILL FOR STRUCTURES
-0.021
-0.021
STA 116+65
STA 116+63 LT BEGIN TREATED TIMBER CURB END STONE FILL TYPE III FOR SLOPE STABILIZATION (STONE FILL TYPE III BEGINS AT STA 116+53 RT).
BEGIN STONE FILL TYPE II FOR SLOPE STABILIZATION.
LIMITS OF GRANULAR BORROW (TYP.)
GRUBBING MATERIAL (TYP.)
1'-0" UNDERCUT
BORING B-8 STA 116+55, 42' LT REFER TO BORING LOG & VAOT ST'D B-5
BORING B-11 STA 116+52, 20' RT REFER TO BORING LOG & VAOT ST'D B-5
GEOTEXTILE UNDER STONE FILL (TYP.)
BEDROCK@ 226.1
330
320
310
300
290
280
-160
-140
-120
-100
-80
-60
-40
-20
0
116+50
289.7
323.60
330
320
310
300
290
280
-160
-140
-120
-100
-80
-60
-40
-20
0
116+00

[redacted]