 
320
310
300
290
-160
-140
-120
-100
-80
320
310
300
290
-160
-140
-120
-100
-80
330
320
310
300
290
-160
-140
-120
-100
-80