 
320
310
-160
-140
-120
-100
-80
-60
-40
-20
320
310
APPROX. LOCATION
EX. TEL. M.H.
LT
POLE
-0.025
-160
-140
-120
-100
-80
-60
-40
-20