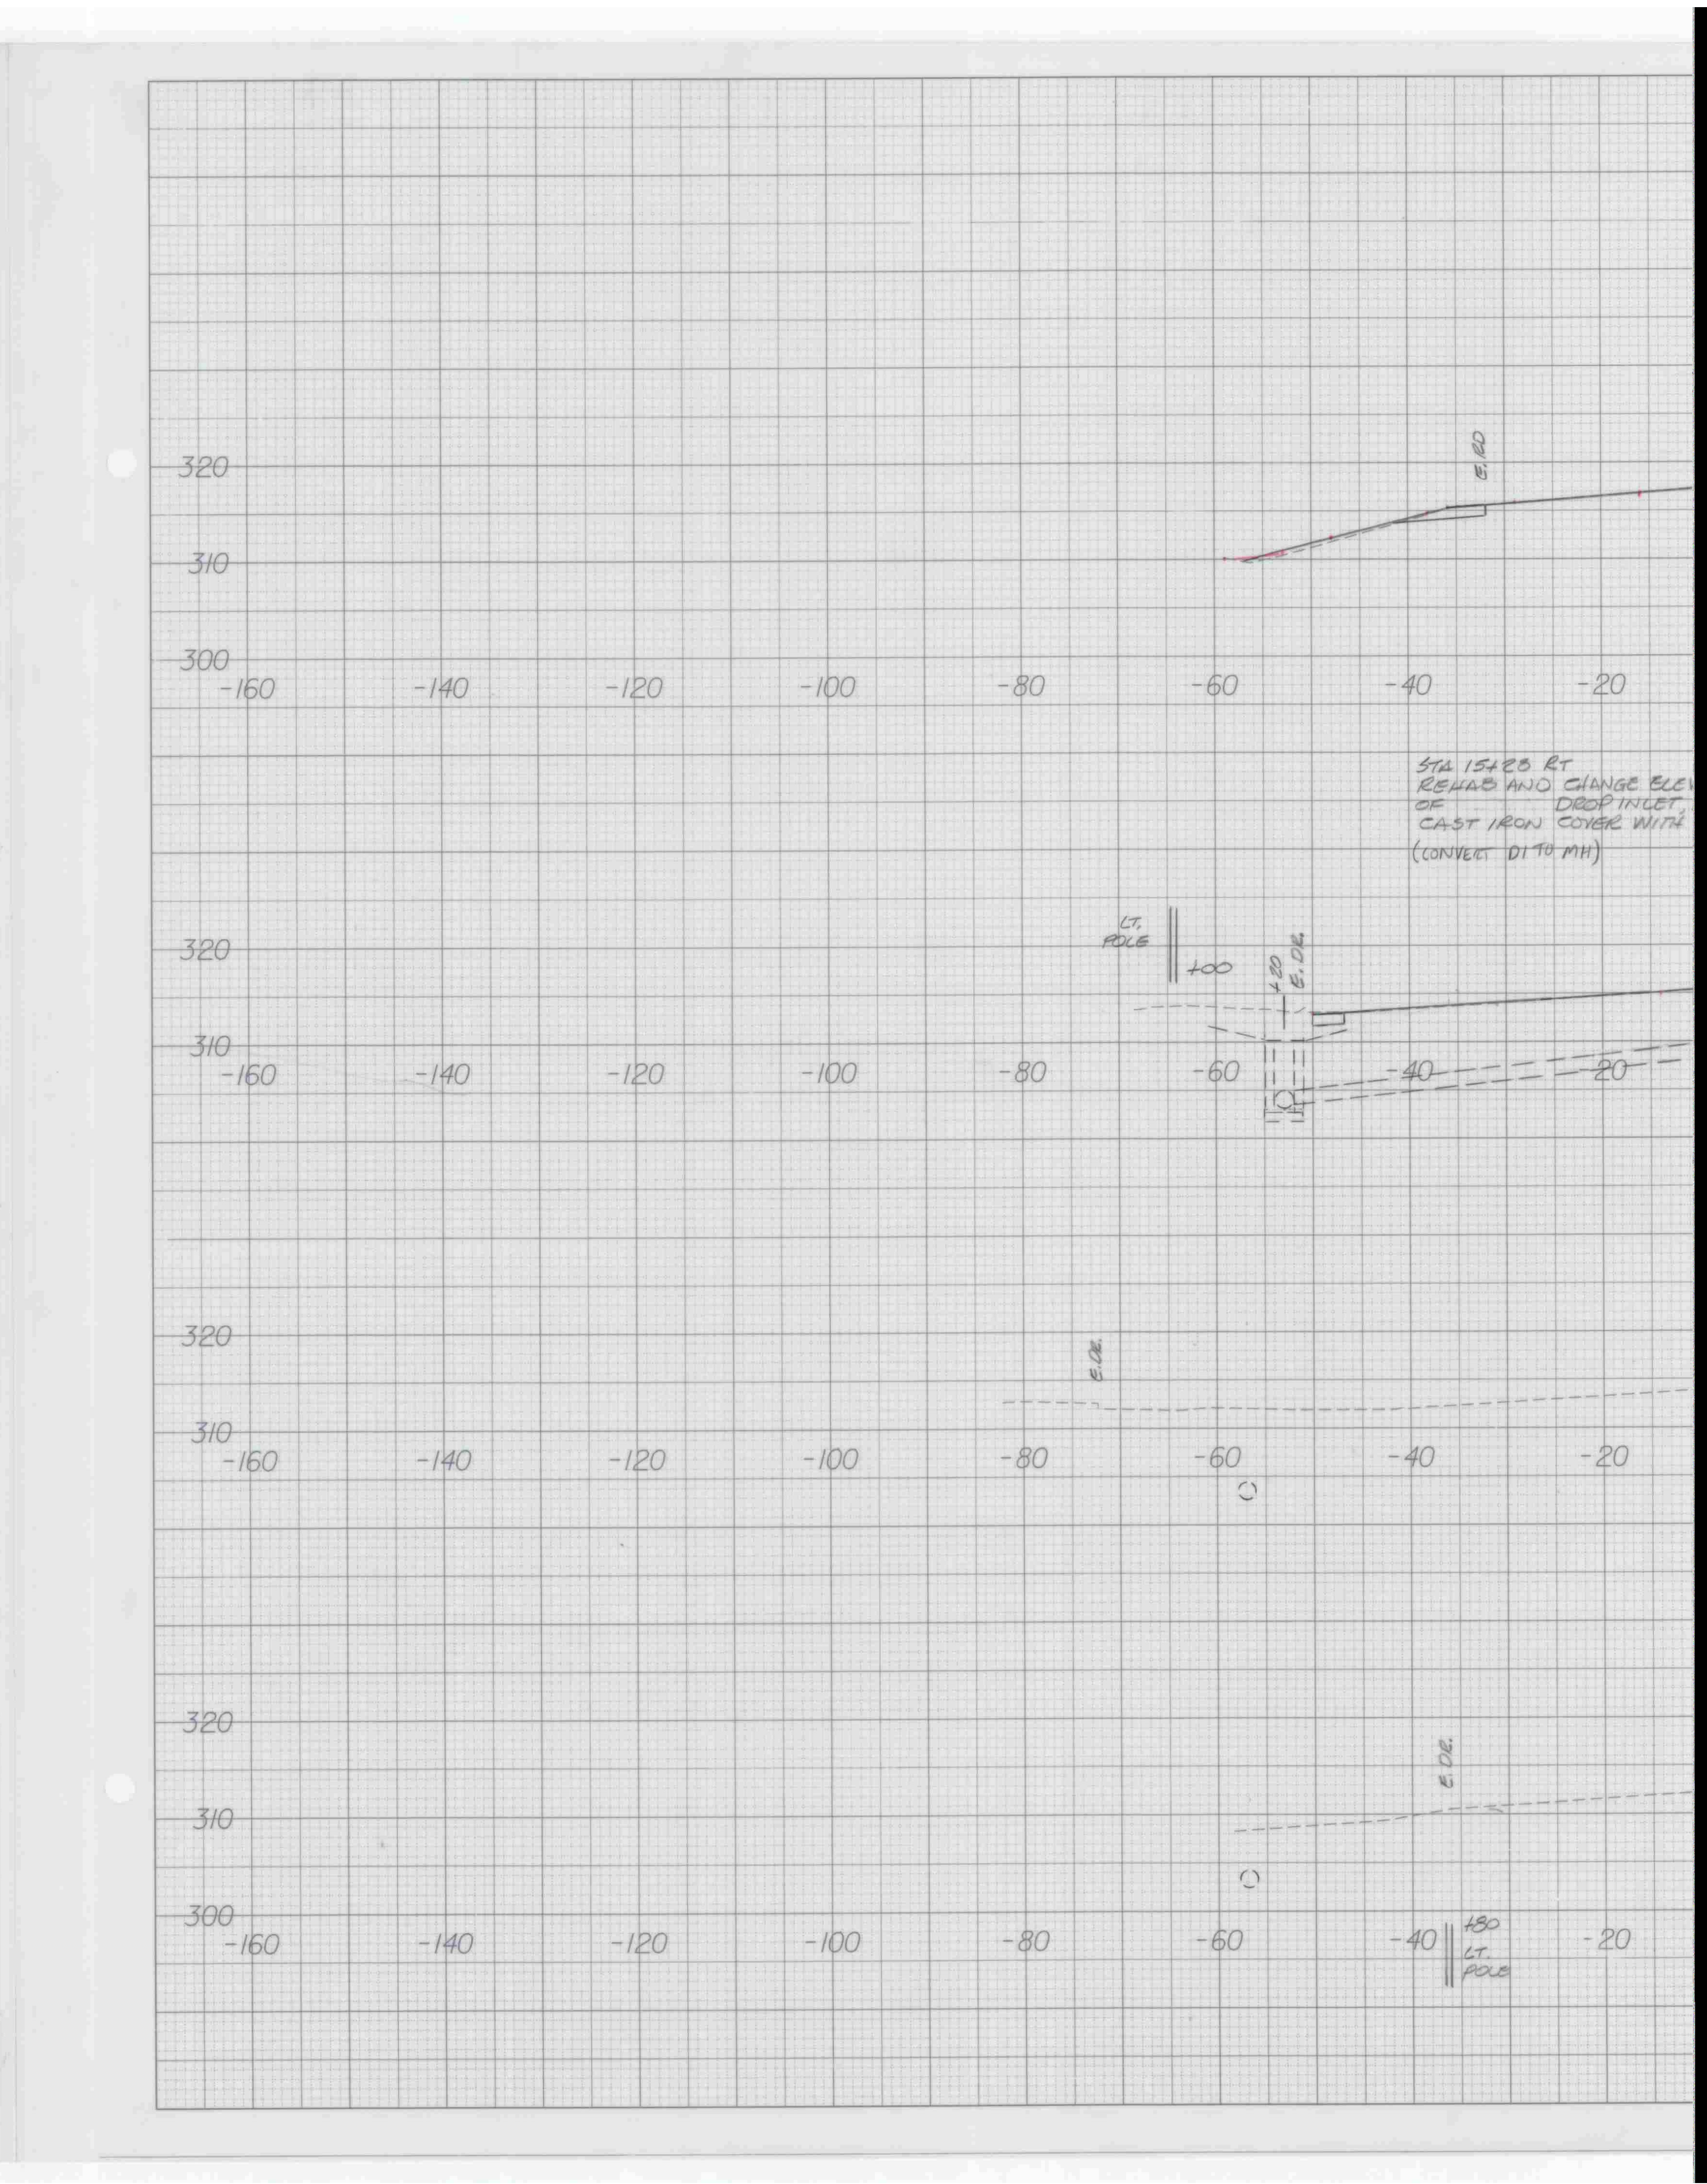

STA 15+28 RT
REHAB AND CHANGE ELE
OF DROP INLET,
CAST IRON COVER WITH
(CONVERT DI TO MH)

320
310
300
-160
-140
-120
-100
-80
-60
-40
-20
E. RD
LT. POLE
+00
+20
E. DR.
E. DR.
E. DR.
+80
LT. POLE

[redacted]