 
330
320
310
-60
-40
-20
0
20
40
60
80
2+00
1+50
1+00
CONSTRUCT DRIVE 0+80 RT
(30' PAVED)
0+50
0+00