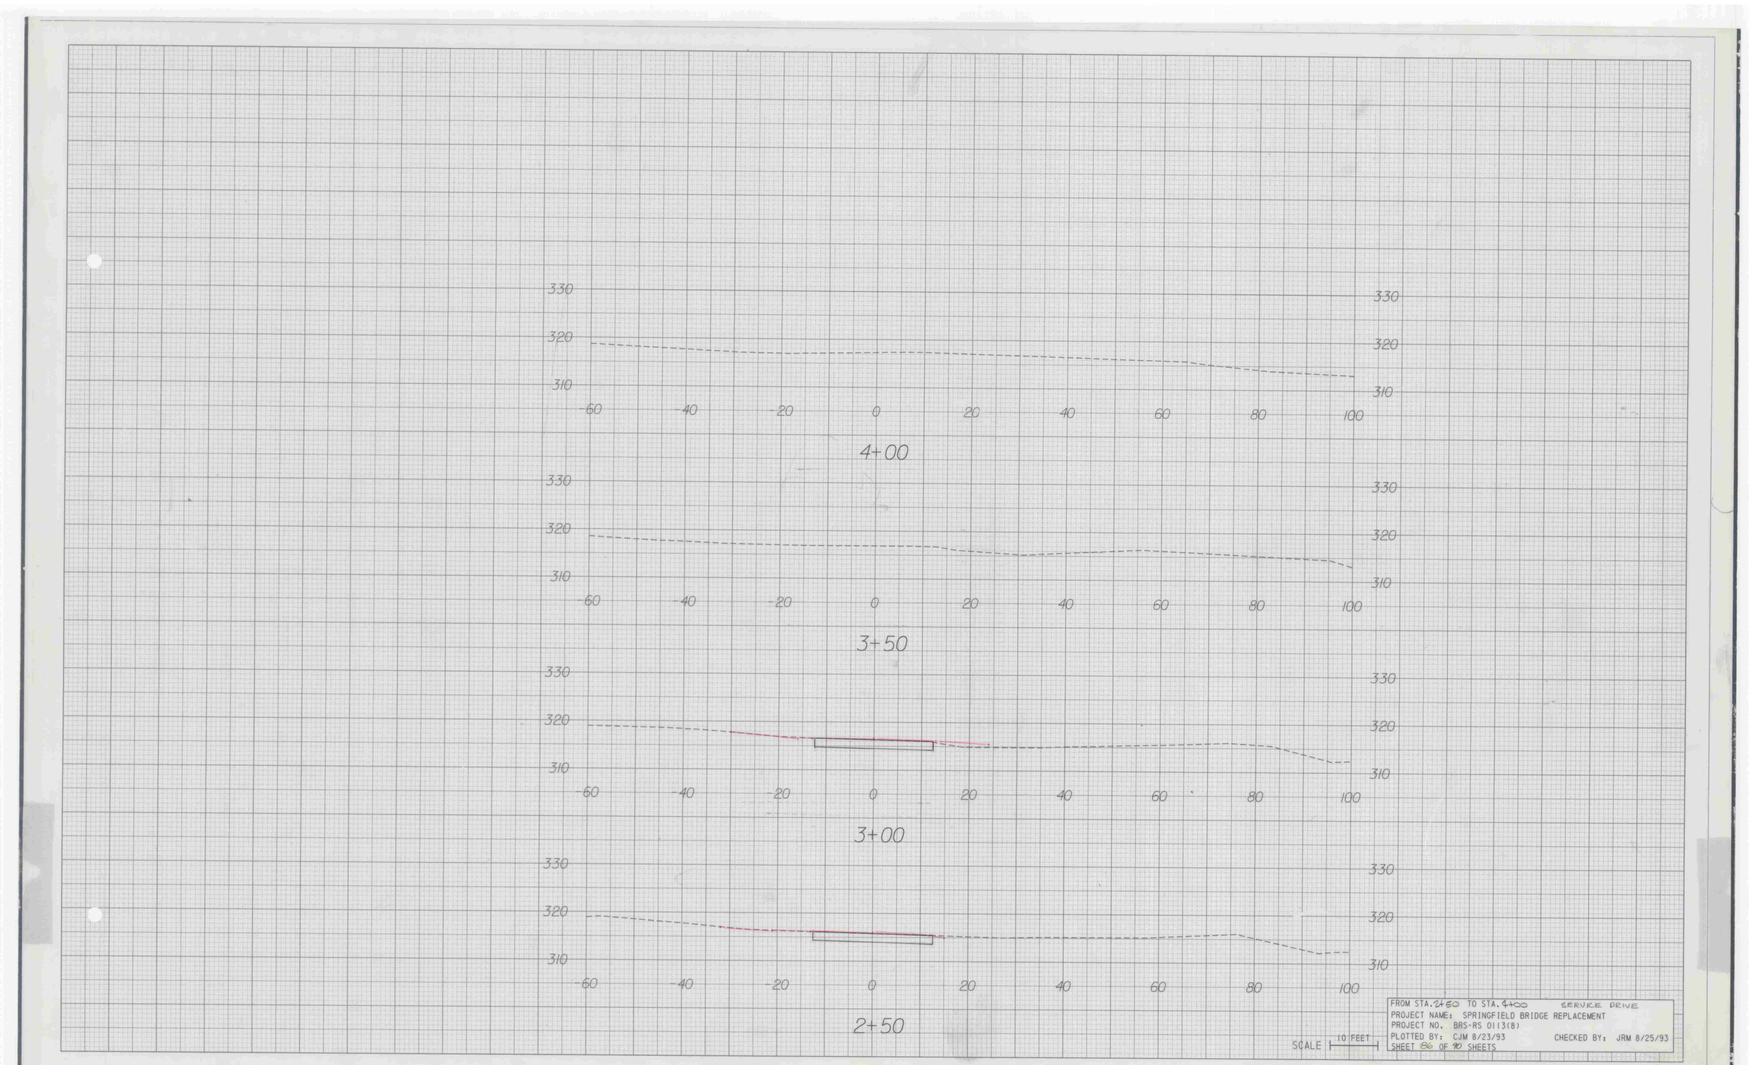

330
320
310
-60
-40
-20
0
20
40
60
80
100
4+00
3+50
3+00
2+50
SCALE
10 FEET
FROM STA. 2+50 TO STA. 4+00 SERVICE DRIVE
PROJECT NAME: SPRINGFIELD BRIDGE REPLACEMENT
PROJECT NO. BRS-RS 0113(8)
PLOTTED BY: CJM 8/23/93
CHECKED BY: JRM 8/25/93
SHEET 86 OF 90 SHEETS