 
330
320
310
300
290
280
-160
-140
-120
-100
LIMITS OF STRUCTURE EXCAVATION (TYP.)
LIMITS OF GRANULAR BORROW (TYP.)
STA. 100+94 LT
END GRUBBING MATERIAL
STA. 100+85 LT
BEGIN STRUCTURE EXCAVATION,
GRANULAR BACKFILL FOR STRUCTURES
330
320
310
300
290
280
-160
-140
-120
-100
LIMITS OF UNCLASSIFIED CHANNEL EXCAVATION (TYP.)