 
320
310
300
290
280
270
-160
-140
-120
BEGIN GRUBBING MATERIAL
320
310
300
290
280
270
-160
-140
-120
LIMITS OF GRAN
BORROW (TYP.)
310
300
290
280
-160
-140
-120
END STRUCTURE EXCAVATION
END GRANULAR BACKFILL FOR ST