 
310
300
101+42
310
300
101+29
310
300
101+15
310
300
101+03
310
300
100+89