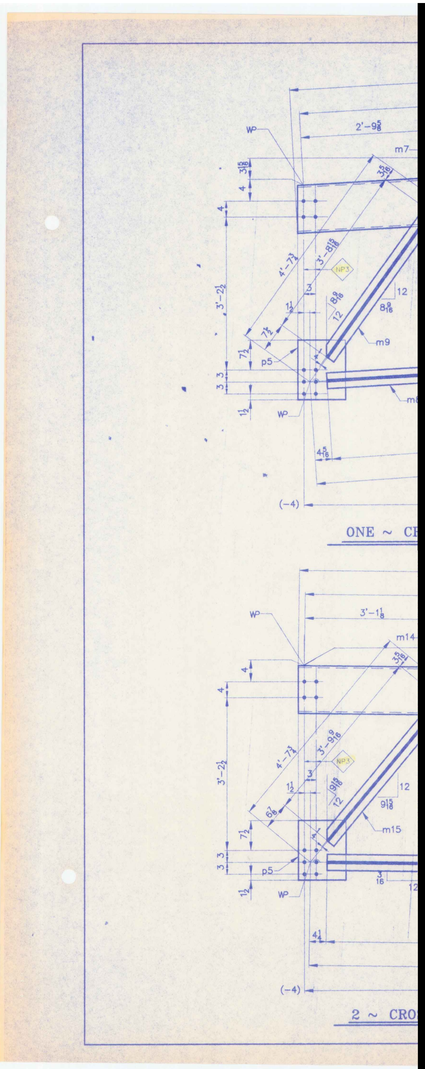

WP
m7
m9
p5
(-4)
ONE ~ CR
WP
m14
m15
p5
(-4)
2 ~ CRO