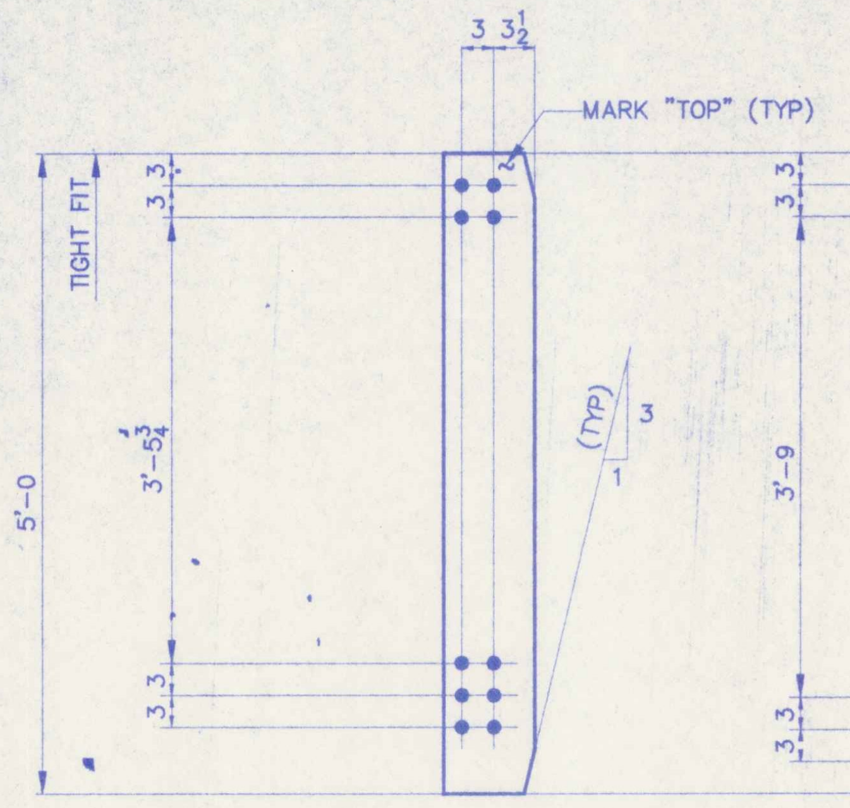
3 3½
MARK "TOP" (TYP)
TIGHT FIT
3 3
5'-0
3'-5¾
(TYP)
3
1
3 3

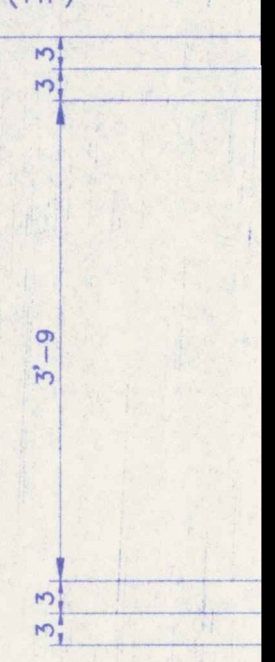

PL ½ x 8 x 5'-0 (2/2)

12 ~ CONN PLS ~ sf1

STFINT

PL ½

72 ~

[redacted]

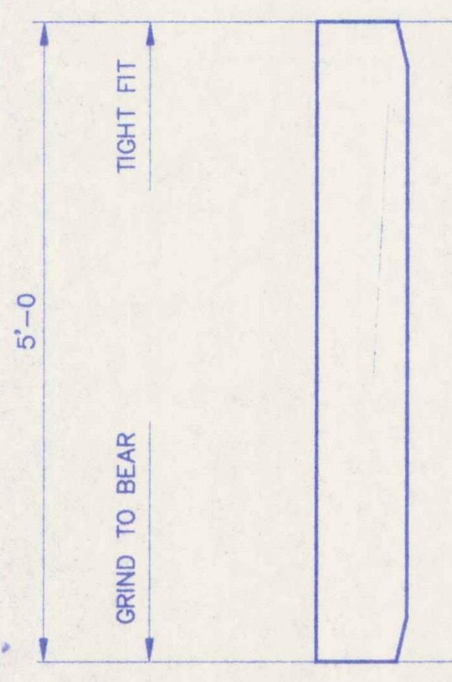
TIGHT FIT
5'-0
GRIND TO BEAR

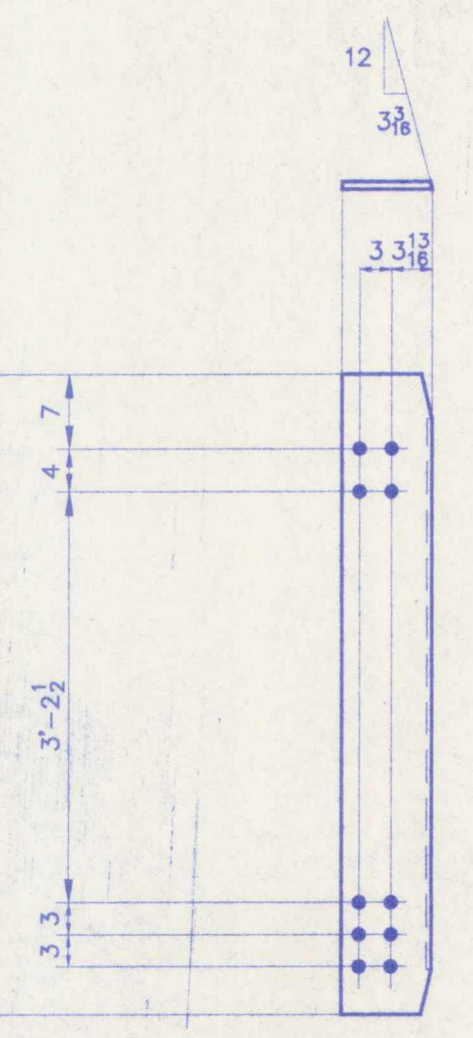
12
$3\frac{3}{16}$
$3\ 3\frac{13}{16}$
7
4
3'-2½
3 3

PL ⅞ x 8½ x 5'-0 (2/1)

6 ~ BRG STIFF ~ bs1

STFBRG

PL ⅞ x 8½ x 5'-0 (

36 ~ BRG STIFF

STFBRS