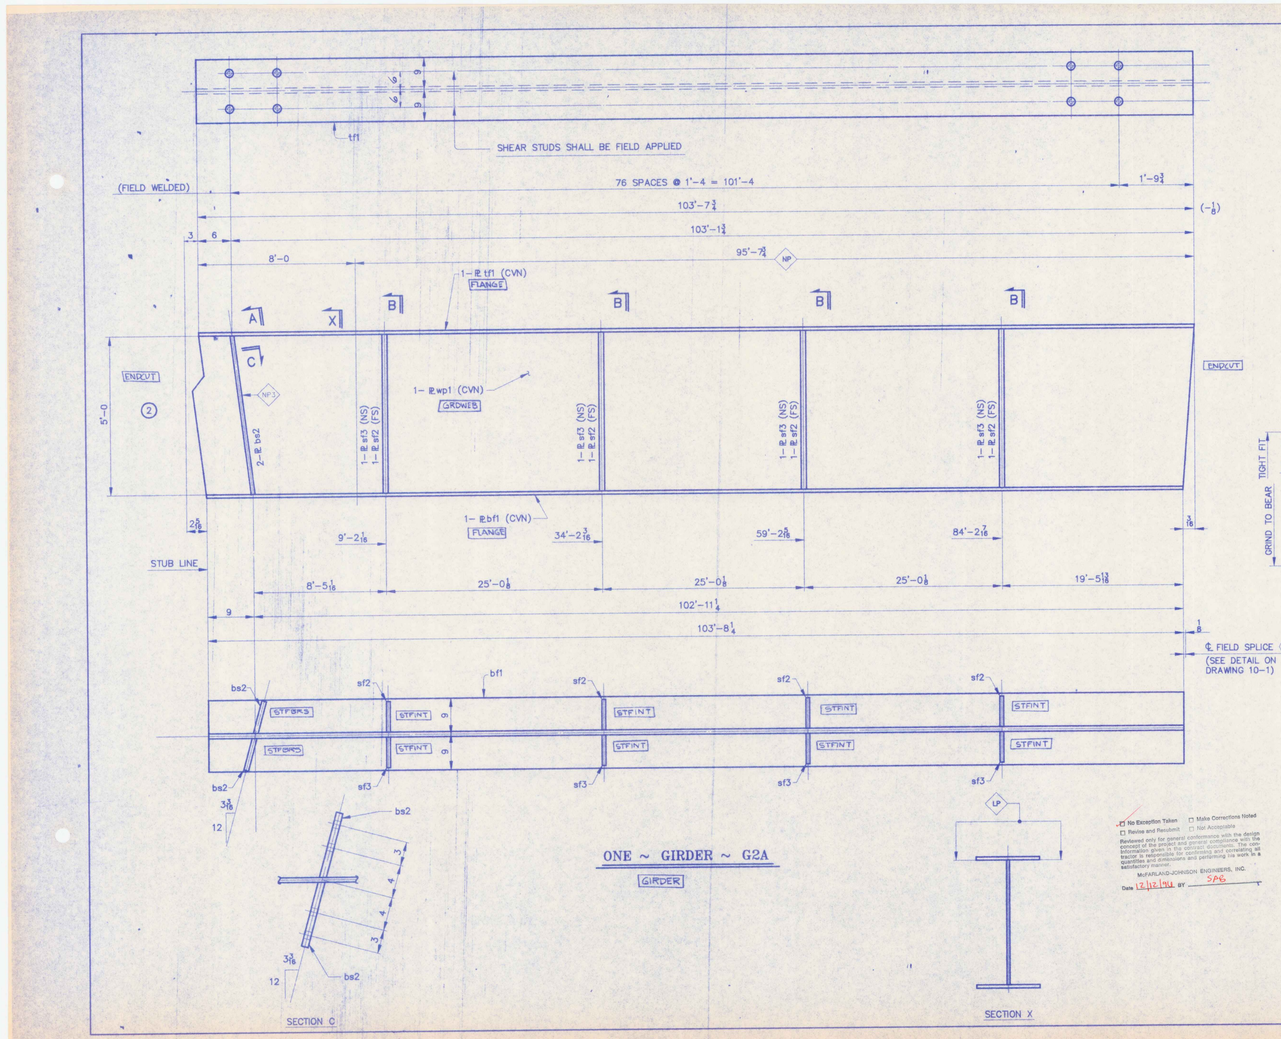

SHIP MARK	NO.	MARK	SHAPE	LENGTH		ITEM NO.	WT.	REMARKS
G2A	ONE		GIRDER					
	1	wp1	PL ⅝ x 60	103	10	3	1322.8	(CVN)
	1	tf1	PL 1⅛ x 18	103	7½	1	874.2	(CVN)
	1	bf1	PL 1⅛ x 18	103	8¼	5	714.5	(CVN)
	2	bs2	PL ⅞ x 8½	5	0	2 1	25.3	F2E
	4	sf2	PL ½ x 8	5	0	2 2	2.7Z	F1E
	4	sf3	PL ½ x 8	5	0	2 2	2.7Z	F1E
							28312	#

WORK ORDER NO. 15713 | DRAWING NO. 10-8 | REV.

NOTES

1. FOR CAMBER DIAGRAM SEE DRAWING 10-4.
2. FOR GIRDER STANDARD DETAILS SEE DRAWING 10-3.
3. (CVN) DENOTES CHARPY TEST REQUIRED.

FOR APPROVAL

No Exception Taken ☐ Make Corrections Noted
☐ Revise and Resubmit ☐ Not Acceptable

Reviewed only for general conformance with the design concept of the project and general compliance with the information given in the contract documents. The contractor is responsible for confirming and correlating all quantities and dimensions and performing his work in a satisfactory manner.

McFARLAND-JOHNSON ENGINEERS, INC.
Date 12/12/96 BY SAG

STEEL: ASTM	A36 ☐ A572 GR ☒ AT09 GR 50W ☐ Unless Noted ☐
WELDING ELECTRODE:	E70 ☒ See Welding Proc. ☐ None ☐
HOLES:	13/16 ☒ 15/16 ☐ 1-1/16 ☐ Unless Noted ☐ As Noted ☐ None ☐
PAINT:	None ☐ Shop Coat ☐ Galv. After Fab. ☒ Unless Noted
SPECIAL PAINT:	SEE SHEET 10-1
SPECIAL CLEANING:	☒ Blast Clean SSPC SP10 ☐ None
ITEM NO. 506.55	BRIDGE NO. 44 PROJ. NO. BRS-RS 0113 (8)
TITLE:	GIRDER ~ G2A

APPROVED:

PRINT DIST.		
5	10-24-96	APPR.
ORIG.	12-3-96	FAB.
5	11-19-96	APP

National Eastern Corporation
Plainville, Connecticut

JOB: U.S. ROUTE 5 OVER BLACK RIVER
SPRINGFIELD, VERMONT

CUSTOMER: WINTERSETT, INC.
DESIGNER: VERMONT AGENCY OF TRANSPORTATION

	WORK ORDER NO.	DRAWING NO.	REV.
CHECKED 10/96 CSD	15713	10-8	
DRAWN 9/96 CSD			