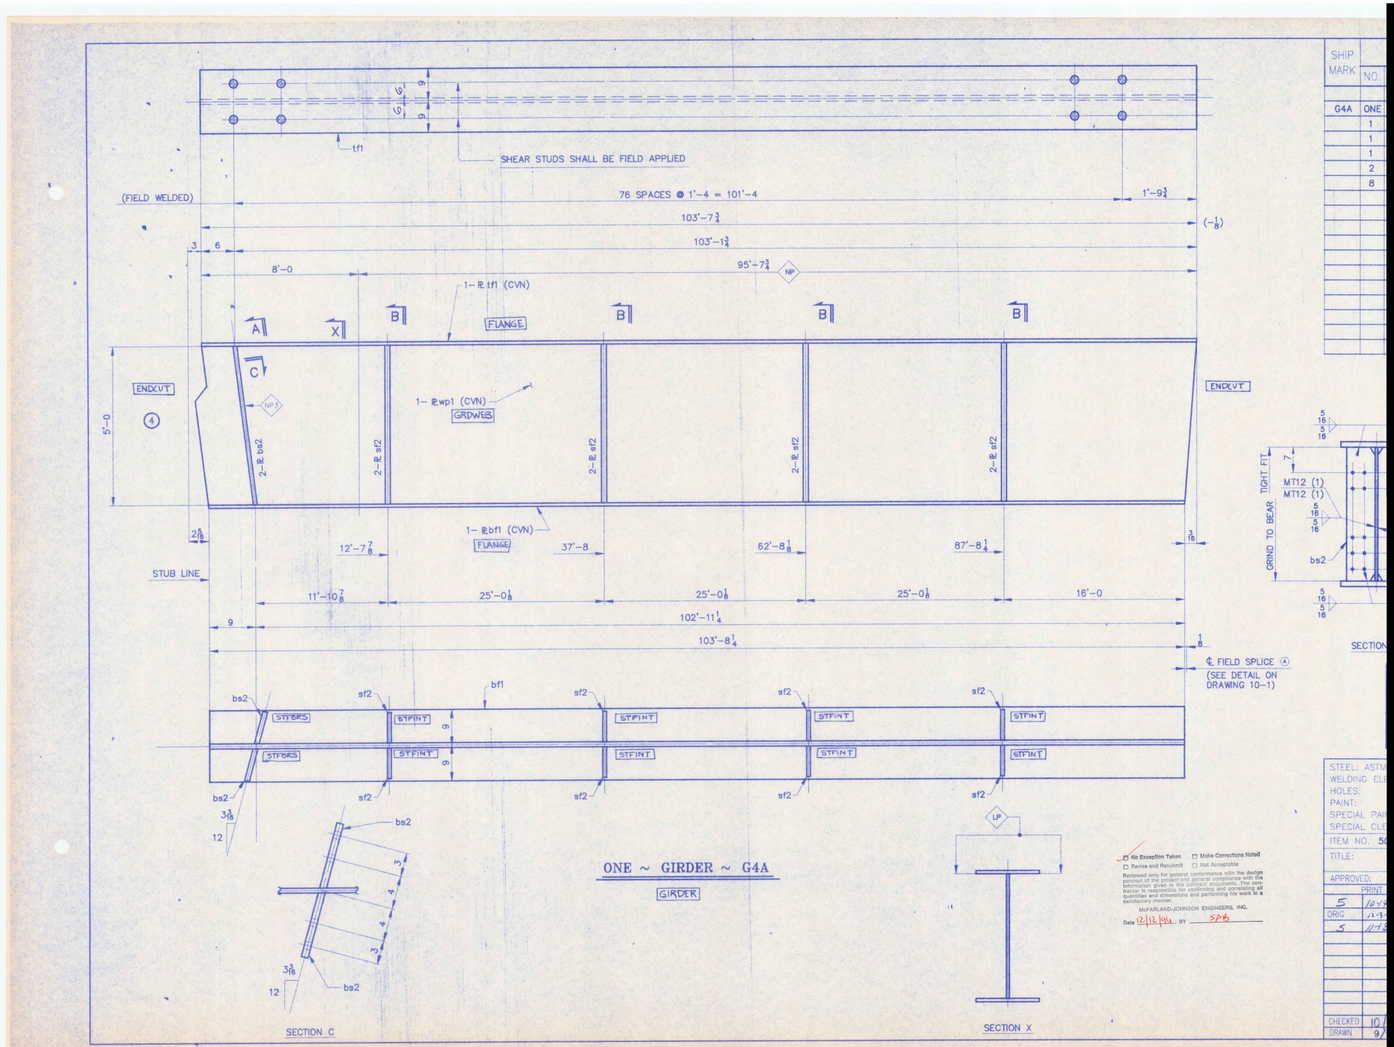

SHIP MARK	NO.
G4A	ONE
	1
	1
	1
	2
	8

STEEL: ASTM
WELDING ELE
HOLES:
PAINT:
SPECIAL PAI
SPECIAL CLE
ITEM NO. 50
TITLE:

APPROVED:

	PRINT
5	12/4
ORIG	12-3-
3	11/2

CHECKED 10/
DRAWN 9/

☐ No Exception Taken ☐ Make Corrections Noted
☐ Revise and Resubmit ☐ Not Acceptable

Reviewed only for general conformance with the design concept of the project and general compliance with the information given in the contract documents. The contractor is responsible for confirming and correlating all quantities and dimensions and performing his work in a satisfactory manner.

MUFARLAND-JOHNSON ENGINEERS, INC.

