 X
1'–10
2'–2
4'–10
5'–2
8'–10
9'–2
12'–10
13'–2
16'–10
17'–2
20'–10
21'–2
24'–10
25'–2
28'–10
29'–2
32'–10
33'–2
36'–10
37'–2
40'–10
41'–2
44'–10
45'–2
48'–10
49'–2
52'–10
53'–2
56'–10
57'–2
60'–10
61'–2
64'–10
65'–2
68'–10
69'–2
72'–10
73'–2
75'–10
76'–2