 
tf1
SHEAR STUDS SHALL BE FIELD APPLIED
(FIELD WELDED)
2'-0
38'-11 1/8
1-℄ tf1 (CVN)
FLANGE
B
FLGSPN
1-℄ fs1
2-℄ fs2
2-℄ ws1
1-℄ wf3(NS)
1-℄ wf2(FS)
1-℄ wp1 (CVN)
GRDWEB
1-℄ bf1 (CVN)
STUB LINE
5'-6 1/16
20'-0 1/8
39'-1 3/16
bf1
sf2
sf3
STFINT
MT
MT12 (1)
TIGHT FIT
GRIND TO BEAR
bs2
SECTION A
SECTION B