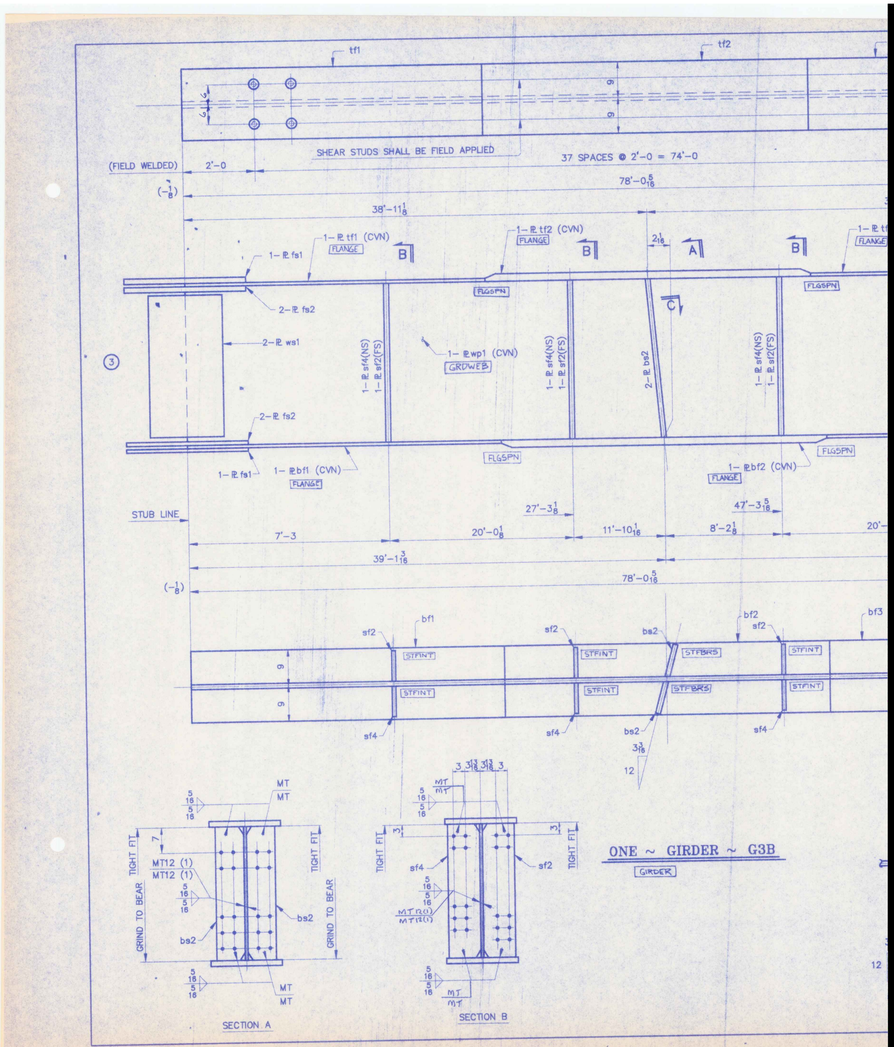
tf1
tf2
SHEAR STUDS SHALL BE FIELD APPLIED
(FIELD WELDED)
2'-0
37 SPACES @ 2'-0 = 74'-0
78'-0 5/16
38'-11 1/8
1-PL tf1 (CVN)
FLANGE
1-PL tf2 (CVN)
FLANGE
2-PL fs2
2-PL ws1
1-PL wp1 (CVN)
GRDWEB
1-PL sf4(NS)
1-PL sf2(FS)
2-PL bs2
FLGSPN
1-PL fs1
1-PL bf1 (CVN)
FLANGE
1-PL bf2 (CVN)
FLANGE
STUB LINE
7'-3
20'-0 1/8
27'-3 1/8
11'-10 1/16
47'-3 5/16
8'-2 1/8
39'-1 3/16
78'-0 5/16
bf1
bf2
bf3
sf2
sf4
bs2
STFINT
STFBRS
3 3 3/16 3 3/16 3
MT
MT12 (1)
TIGHT FIT
GRIND TO BEAR
SECTION A
SECTION B
ONE ~ GIRDER ~ G3B
GIRDER