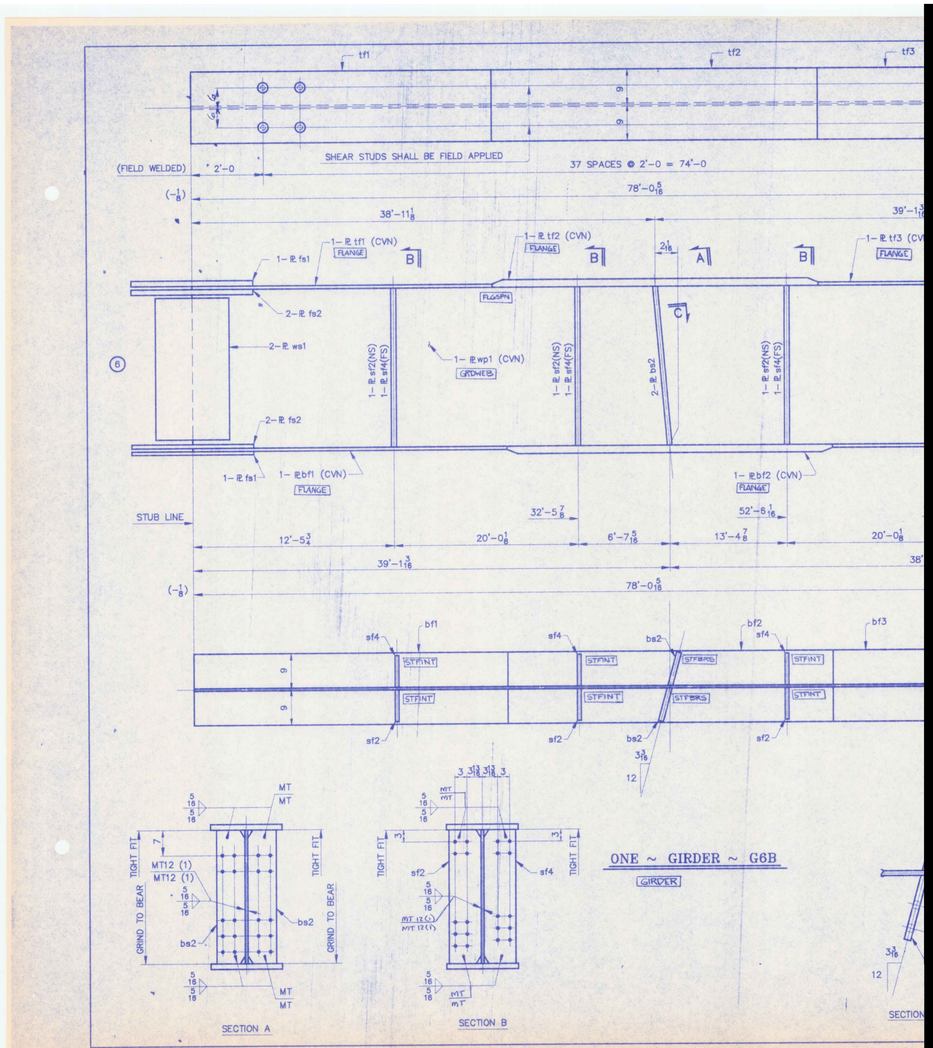
tf1
tf2
tf3
SHEAR STUDS SHALL BE FIELD APPLIED
(FIELD WELDED)
2'-0
37 SPACES @ 2'-0 = 74'-0
78'-0 5/16
38'-11 1/8
39'-1 3/16
1-PL tf1 (CVN) FLANGE
1-PL tf2 (CVN) FLANGE
1-PL tf3 (CVN) FLANGE
FLGSPN
1-PL fs1
2-PL fs2
2-PL ws1
1-PL wp1 (CVN) GRDWEB
1-PL sf2(NS) 1-PL sf4(FS)
2-PL bs2
1-PL bf1 (CVN) FLANGE
1-PL bf2 (CVN) FLANGE
STUB LINE
12'-5 3/4
20'-0 1/8
6'-7 5/16
13'-4 7/8
20'-0 1/8
32'-5 7/8
52'-6 1/16
bf1
bf2
bf3
sf4
bs2
sf2
STFNT
STFBRG
STFBRS
MT12 (1)
TIGHT FIT
GRIND TO BEAR
SECTION A
SECTION B
ONE ~ GIRDER ~ G6B
GIRDER