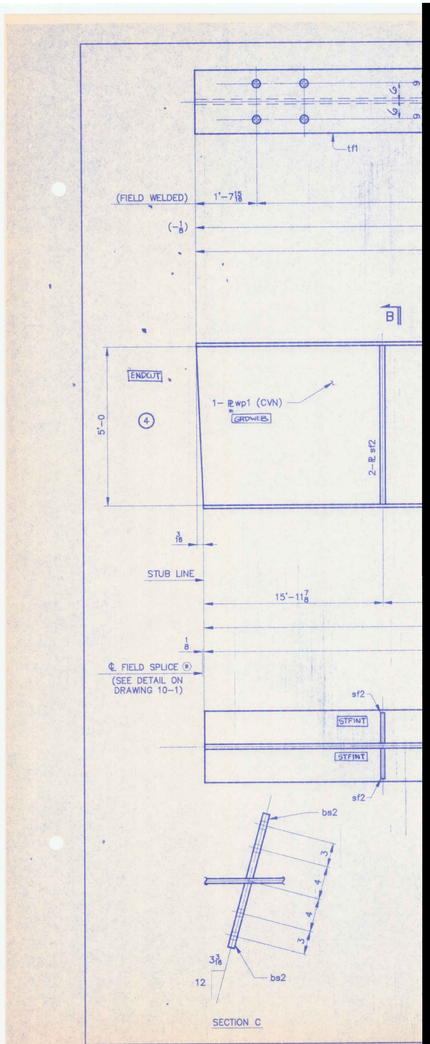

tf1
(FIELD WELDED)
1'-7 15/16
(-1/8)
B
ENDCUT
1- PL wp1 (CVN)
GROWEB
5'-0
4
2- PL sf2
3/16
STUB LINE
15'-11 7/8
1/8
℄ FIELD SPLICE
(SEE DETAIL ON DRAWING 10-1)
sf2
STFINT
STFINT
sf2
bs2
3
4
4
3
3 3/16
12
bs2
SECTION C

[redacted]