FINAL SURVEY	BY	DATE
SURVEYED		
PLOTTED		
TEMPLATE		
NOTE BOOK AREAS		
NO. AREAS CHECKED		

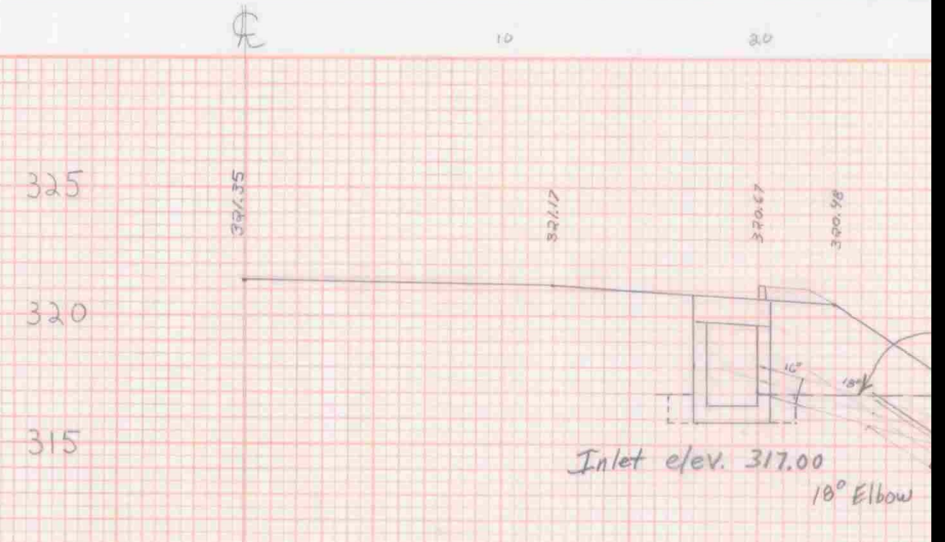
℄
10
20
325
320
315
321.35
321.17
320.67
320.98
10°
18°

Inlet elev. 317.00
18° Elbow

[redacted]

Trench Eart

Pipe 43.4' X 3.1'

DI 5'X 4.2'X

Stone fill

BK.2, Pg. 88

116+65 RT.
12 x ~~40~~ 40' 36' CSP 0.064
2-~~28~~ 18° Elbows

28 L.F. of 12" C.S
installed 1/6/97 M.W.

12 L.F. of 12" C.S
installed 5/20/97 M.

ORIGINAL SURVEY	BY	DATE
SURVEYED	Ross, Hoagland, DeAngelis	10-2-96
PLOTTED	Ross	10-2-96
TEMPLATE	Ross	10-3-96
NOTE BOOK AREAS		
NO. AREAS CHECKED		

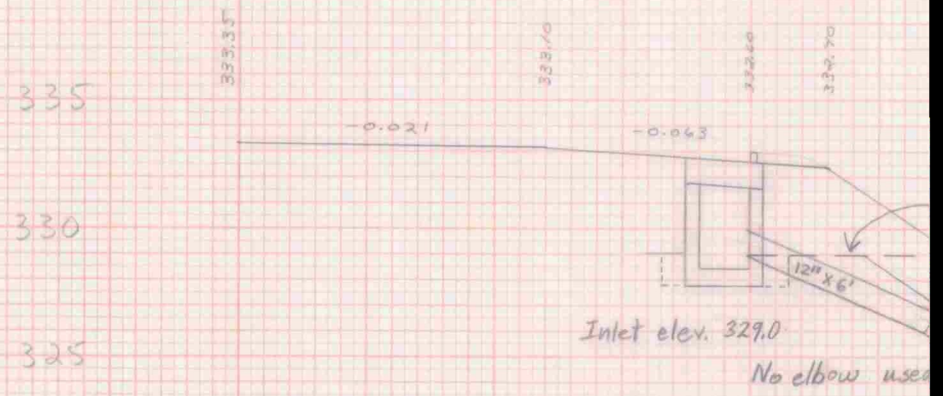
335
330
333.35
333.10
332.60
332.70
-0.021
-0.063
12" X 6'

Inlet elev. 329.0

No elbow use

1 P.R.C.C. D.I. + 6 L.F. of 12" C.S.P.
installed 5/5/97 M.W.H.

1-
38
4/

Trench E

.53

DI 5

Stone

113+20 RT.

Bk. 2, Pg. 80

12" x ~~35~~ 38' 41' CSP 0.064
12-~~28~~ 18° Elbows

325
320
315
310
305
300
295
290
℄
10
20