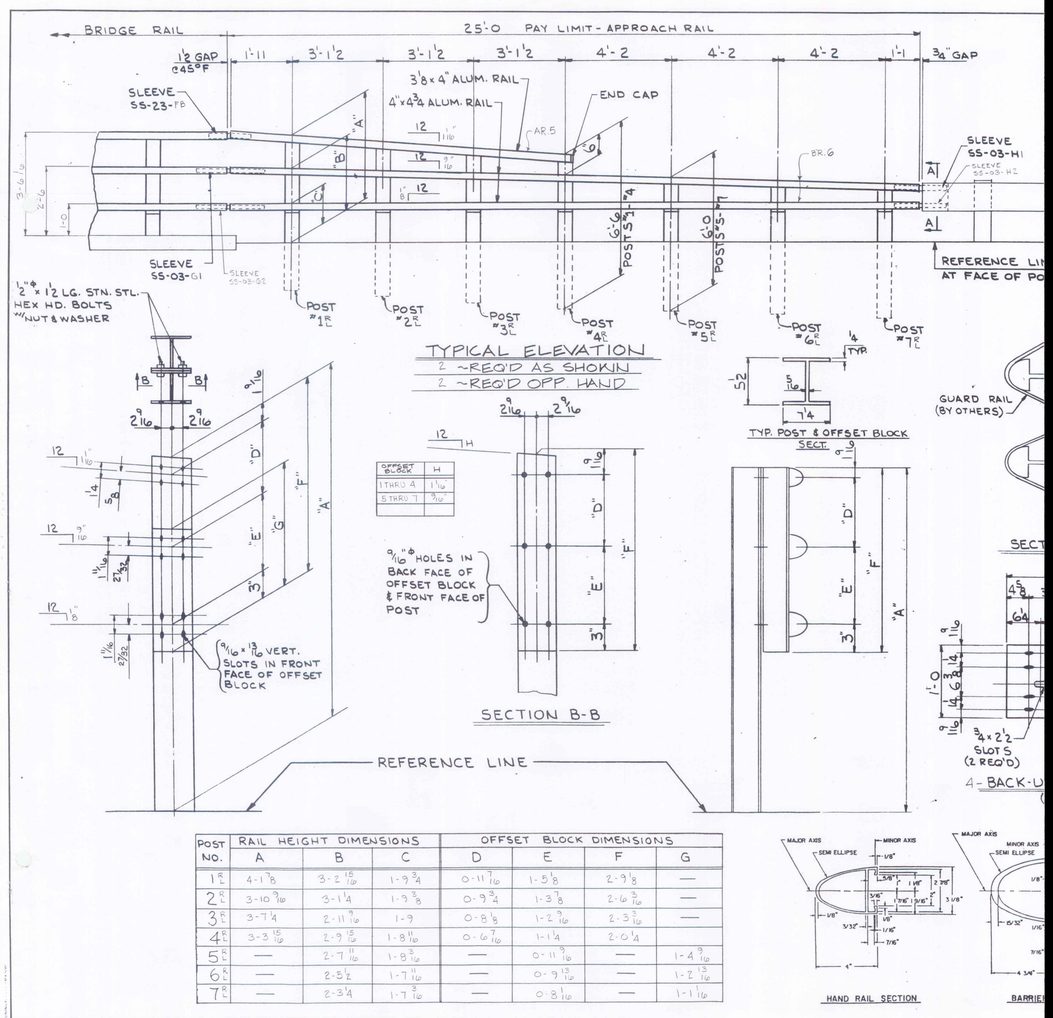

OFFSET BLOCK	H
1 THRU 4	1 1/16
5 THRU 7	9/16

POST NO.	RAIL HEIGHT DIMENSIONS A	B	C	OFFSET BLOCK DIMENSIONS D	E	F	G
1 R/L	4-1 3/8	3-2 15/16	1-9 3/4	0-11 7/16	1-5 1/8	2-9 1/8	—
2 R	3-10 9/16	3-1 1/4	1-9 3/8	0-9 3/4	1-3 3/8	2-6 5/16	—
3 L	3-7 1/4	2-11 9/16	1-9	0-8 3/8	1-2 9/16	2-3 5/16	—
4 R	3-3 15/16	2-9 5/16	1-8 11/16	0-6 7/16	1-1 1/4	2-0 1/4	
5 R	—	2-7 11/16	1-8 3/16	—	0-11 7/16	—	1-4 9/16
6 R	—	2-5 1/2	1-7 11/16	—	0-9 13/16	—	1-2 13/16
7 R	—	2-3 1/4	1-7 3/16	—	0-8 1/16	—	1-1 1/16