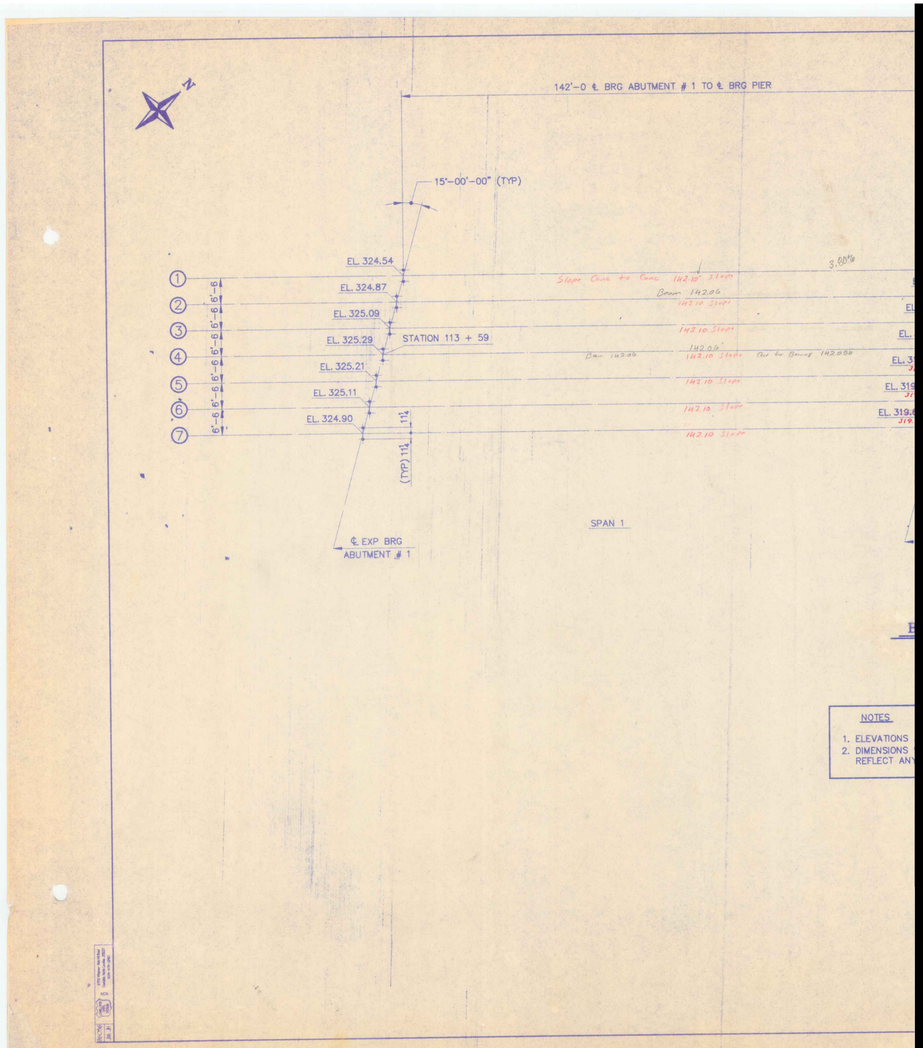
N
142'-0 ℄ BRG ABUTMENT # 1 TO ℄ BRG PIER
15'-00'-00" (TYP)
EL. 324.54
EL. 324.87
EL. 325.09
EL. 325.29
STATION 113 + 59
EL. 325.21
EL. 325.11
EL. 324.90
1:1½
(TYP) 1:1½
℄ EXP BRG
ABUTMENT # 1
SPAN 1
Slope Cont. to Conc. 142.10 Slope
Beam 142.06
142.10 Slope
142.00'
142.10 Slope
Dim to Beam 142.06
142.10 Slope
142.10 Slope
142.10 Slope
3.00%
NOTES
1. ELEVATIONS
2. DIMENSIONS
REFLECT ANY