 
℄ FIELD SPLICE (A)
WP
1/8
5'-0
90°
WP
℄ BRG
℄ PIER
MT12 (
MT12 (
5/16
5/16
℄ 5/8 x 60 x 78'-0 5/16 ~ wp1(1/4)
1 1/8 x 18 x 24'-11 3/8 ~ tf1(1/6)
2 1/8 x 18 x 28'-0 ~ tf2(1/7)
78'-0 5/16
38'-11 3/8
39'-1 3/8
4'-11 7/8
14 @ 5'-0 = 70'-0
78'-0 5/16
1 1/8 x 18 x 25'-1 3/16 ~ bf1(1/6)
2 1/8 x 18 x 28'-0 ~ bf2(1/7)
CAMBER DIAGRAMS ~ G1B THRU G7