[redacted]

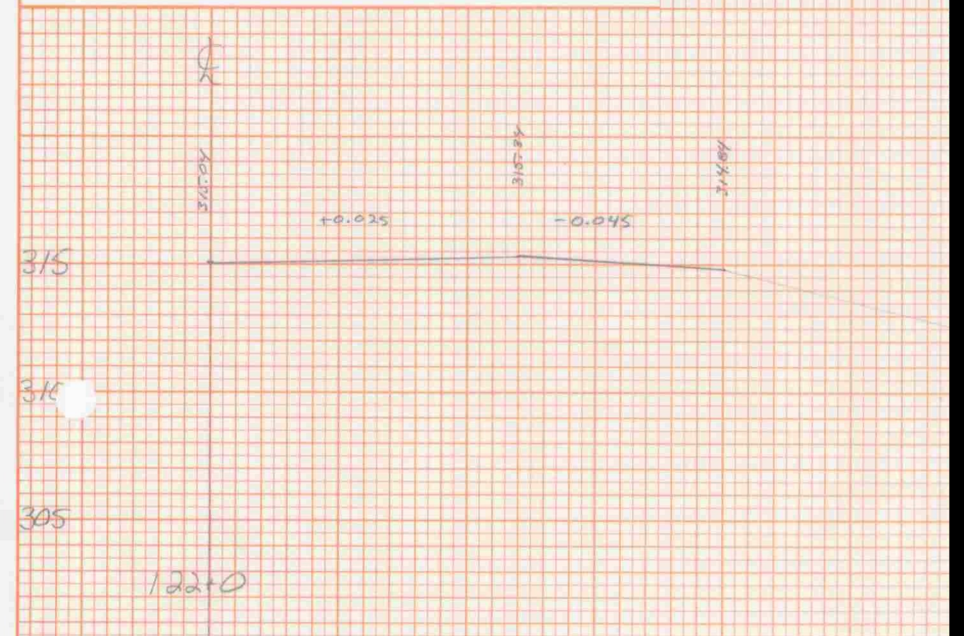
℄
315.01
+0.025
−0.045
315
310
305
122+0

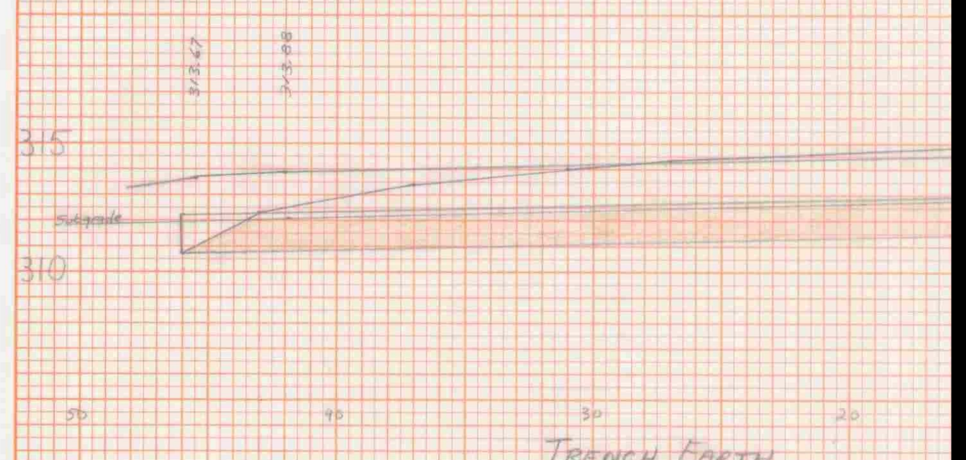
313.67
313.88
315
Subgrade
310
50
40
30
20

TRENCH EARTH
123.0 × 3.6 = 442.8 ft³ ÷ 27

Bored a hole into the existing D.I.
for the 18" C.S.P. outlet 6/16/97 M.W.H.

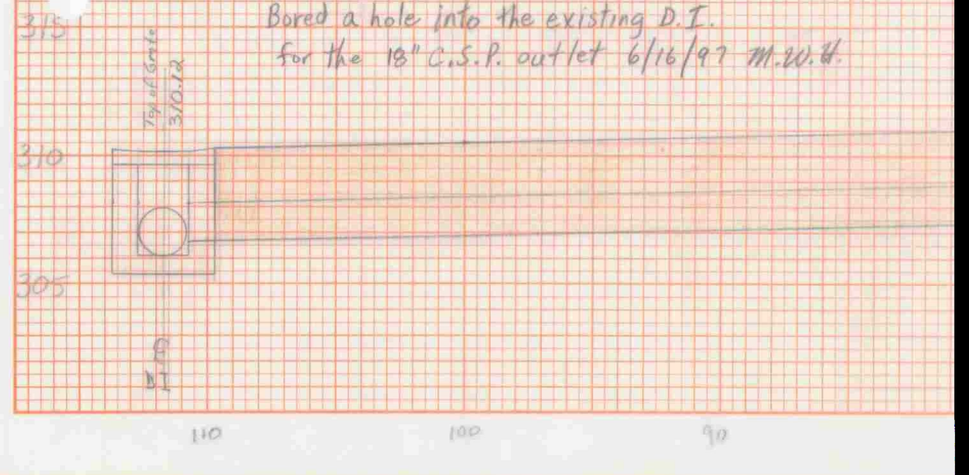
Top of Grate
310.12
315
310
305
D.I.
110
100
90