FINAL SURVEY
NOTE BOOK
NO.
SURVEYED
PLOTTED
TEMPLATE
AREAS
AREAS CHECKED
BY
DATE

ORIGINAL SURVEY
NOTE BOOK
NO.
SURVEYED
PLOTTED
TEMPLATE
AREAS
AREAS CHECKED
BY
DATE

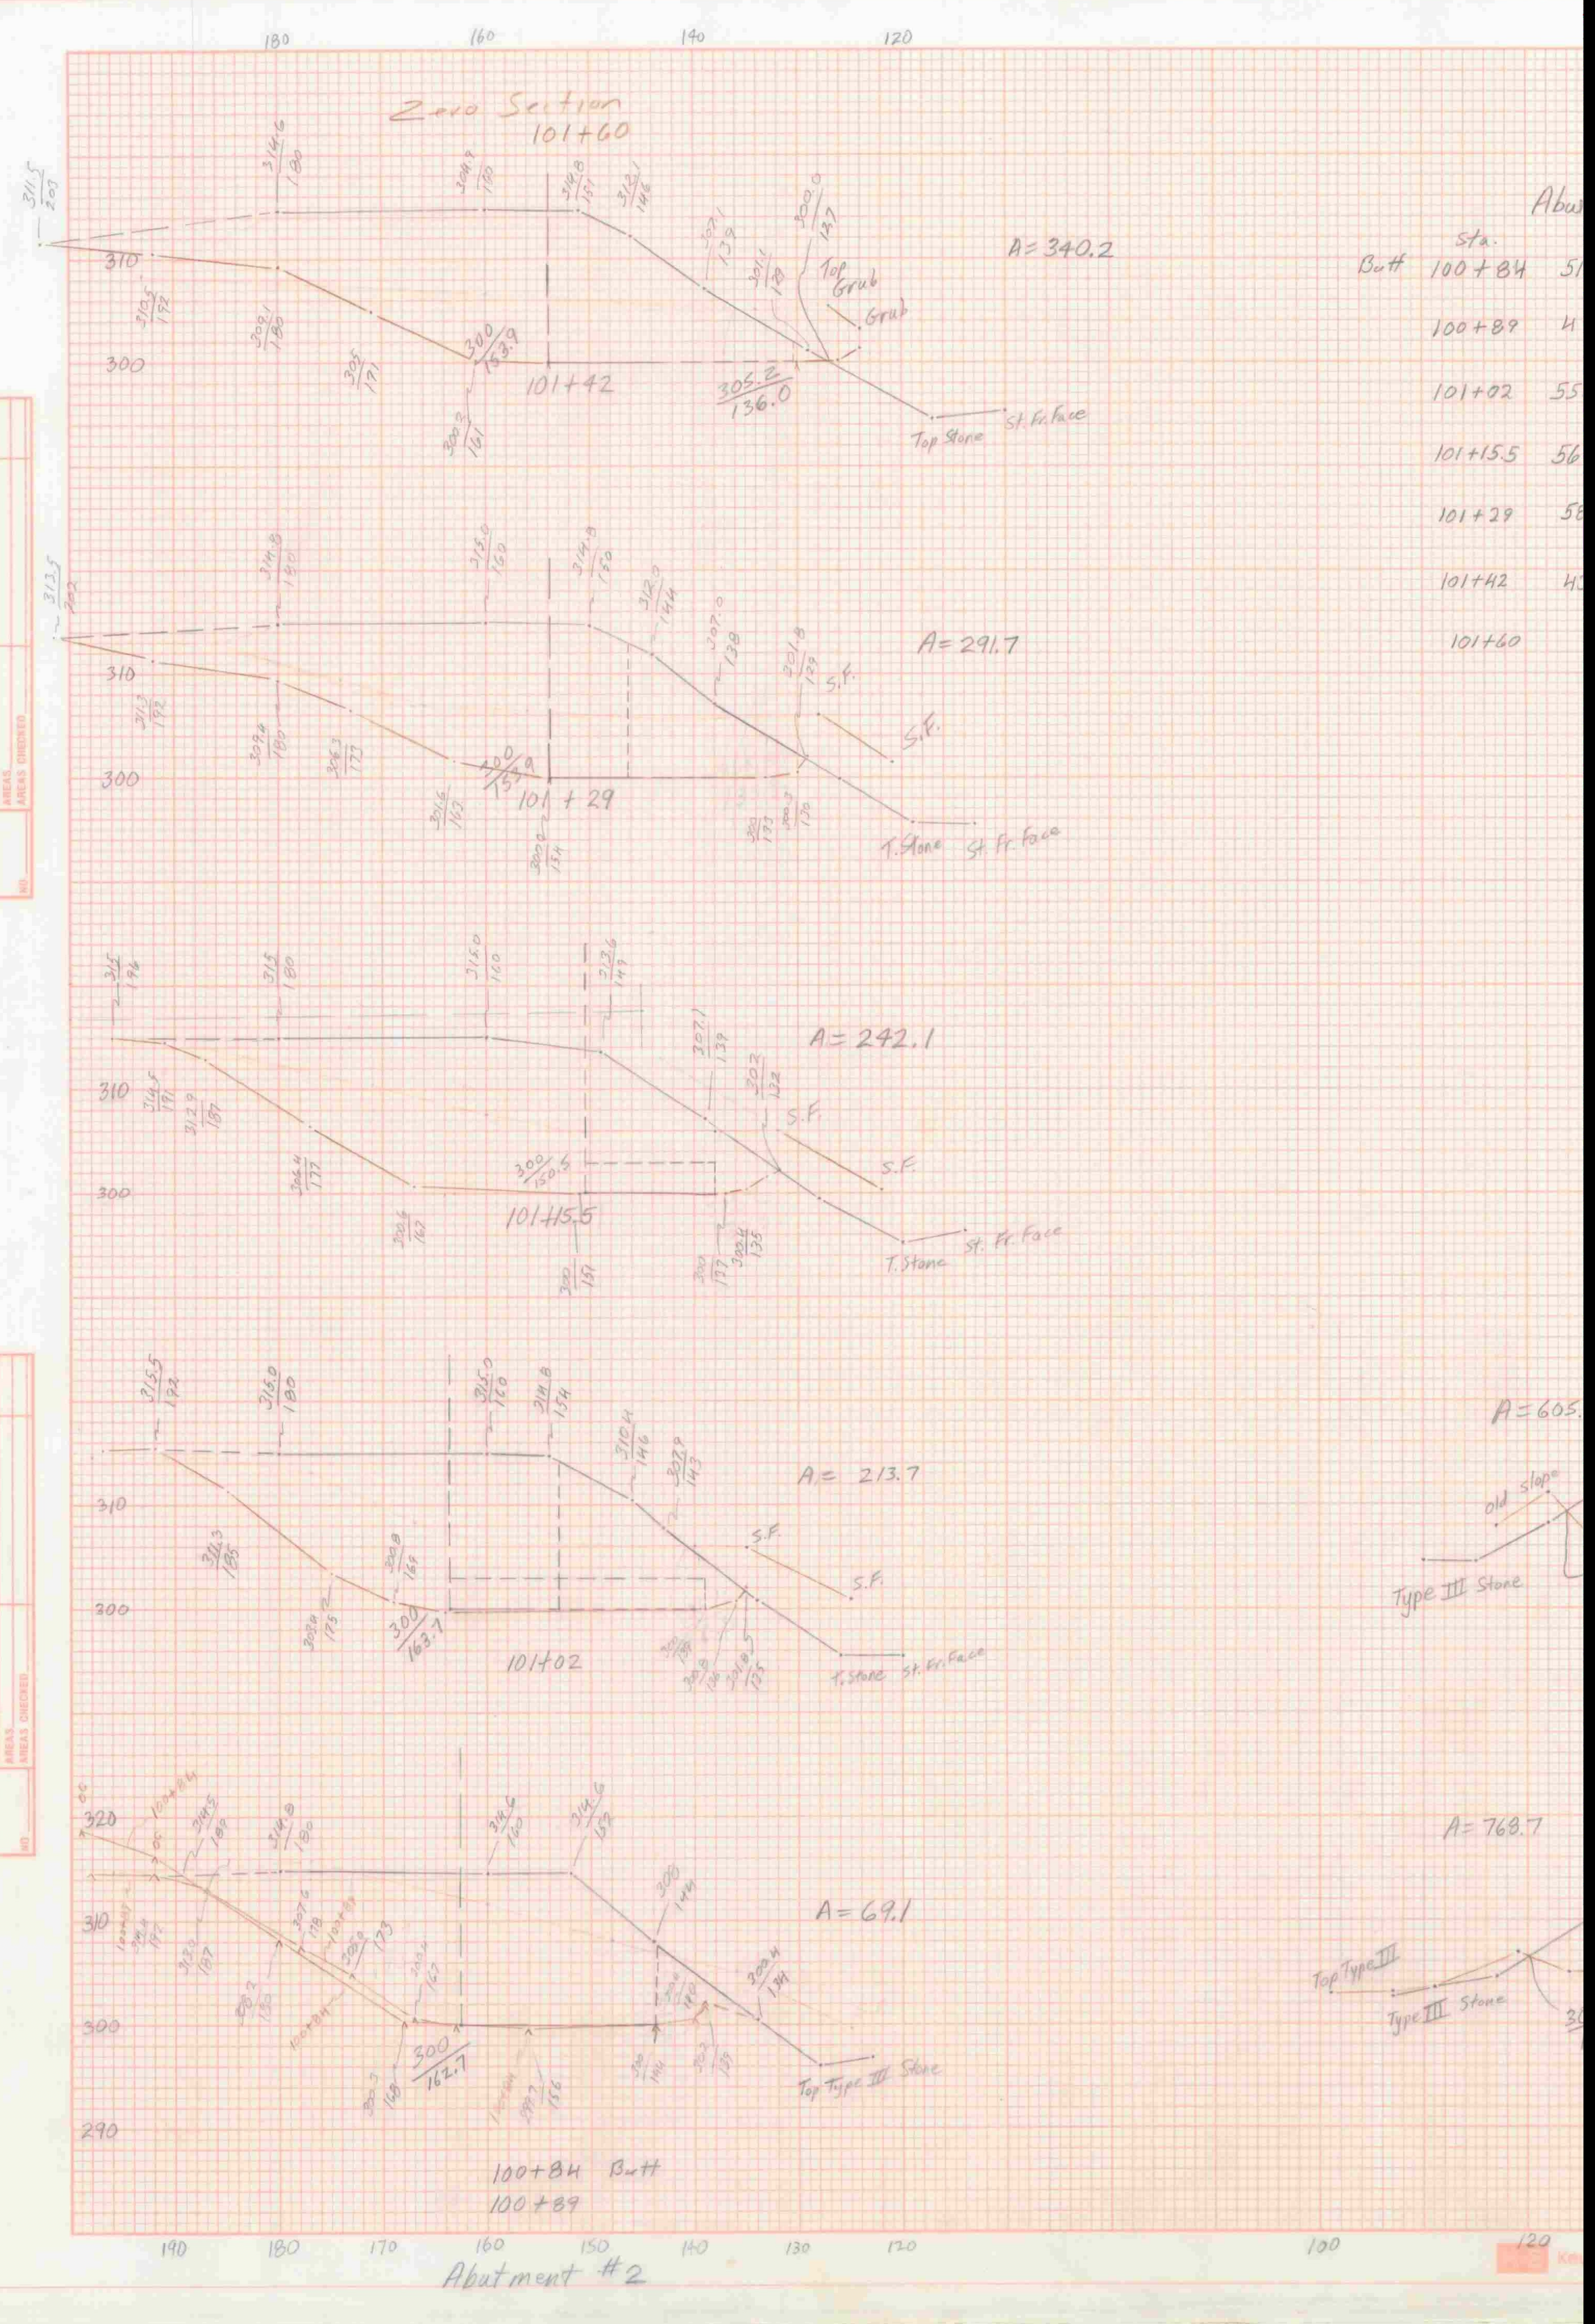

180
160
140
120
Zero Section
101+60
A=340.2
101+42
305.2
136.0
Top Grub
Grub
Top Stone
St. Fr. Face
A=291.7
101+29
S.F.
T. Stone
St. Fr. Face
A=242.1
101+15.5
S.F.
T. Stone
St. Fr. Face
A=213.7
101+02
S.F.
T. Stone
St. Fr. Face
A=69.1
300
162.7
Top Type III Stone
100+84 Butt
100+89
320
310
300
290
190
180
170
160
150
140
130
120
100
Abutment #2
A=605.
old slope
Type III Stone
A=768.7
Top Type III
Type III Stone

Abu

	Sta.	
Butt	100+84	51
	100+89	4
	101+02	55
	101+15.5	56
	101+29	58
	101+42	43
	101+60	

[redacted]