Item 649.31, Geotextile Under Stone Fill

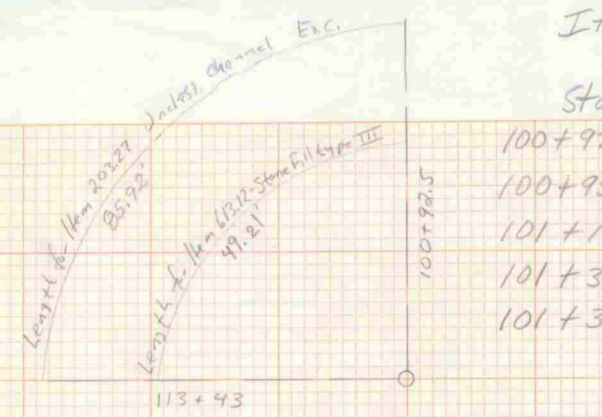
Length for Item 203.27 Unclass. Channel Exc.
85.92'
Length for Item 613.12 Stone Fill type III
49.21'
100+92.5
113+43

Sta.	Length	Sta. Dist.	
100+92.50	83' ✓	3.10' ✓	217.0 ✓
100+95.60	57' ✓	19.40' ✓	1125.2 ✓
101+15	59' ✓	21.0' ✓	1239.0 ✓
101+36	59' ✓	2.5' ✓	178.8 ✓
101+38.5	84' ✓		2760 ✓

M.W.H. 9/23/97
LPT 25 Sep 97

Item 649.31 (Cont)

Sta	Length	Dist	Area SF
100+92.5	83 ✓	85.92/2 42.96 ✓	3307.9 SF ✓
113+43	71 ✓		
101+38.5	84 ✓	57.5/2 28.75 ✓	2026.9 SF ✓
113+26	57 ✓		Σ 5334.8 SF ✓

LPT 25Sep97
M.W.H. 9/30/97

Total Item 649.31
2760 + 5334.8 = 8094.8/9 = 899.4 SY ✓
LPT 25Sep97
M.W.H. 9/30/97

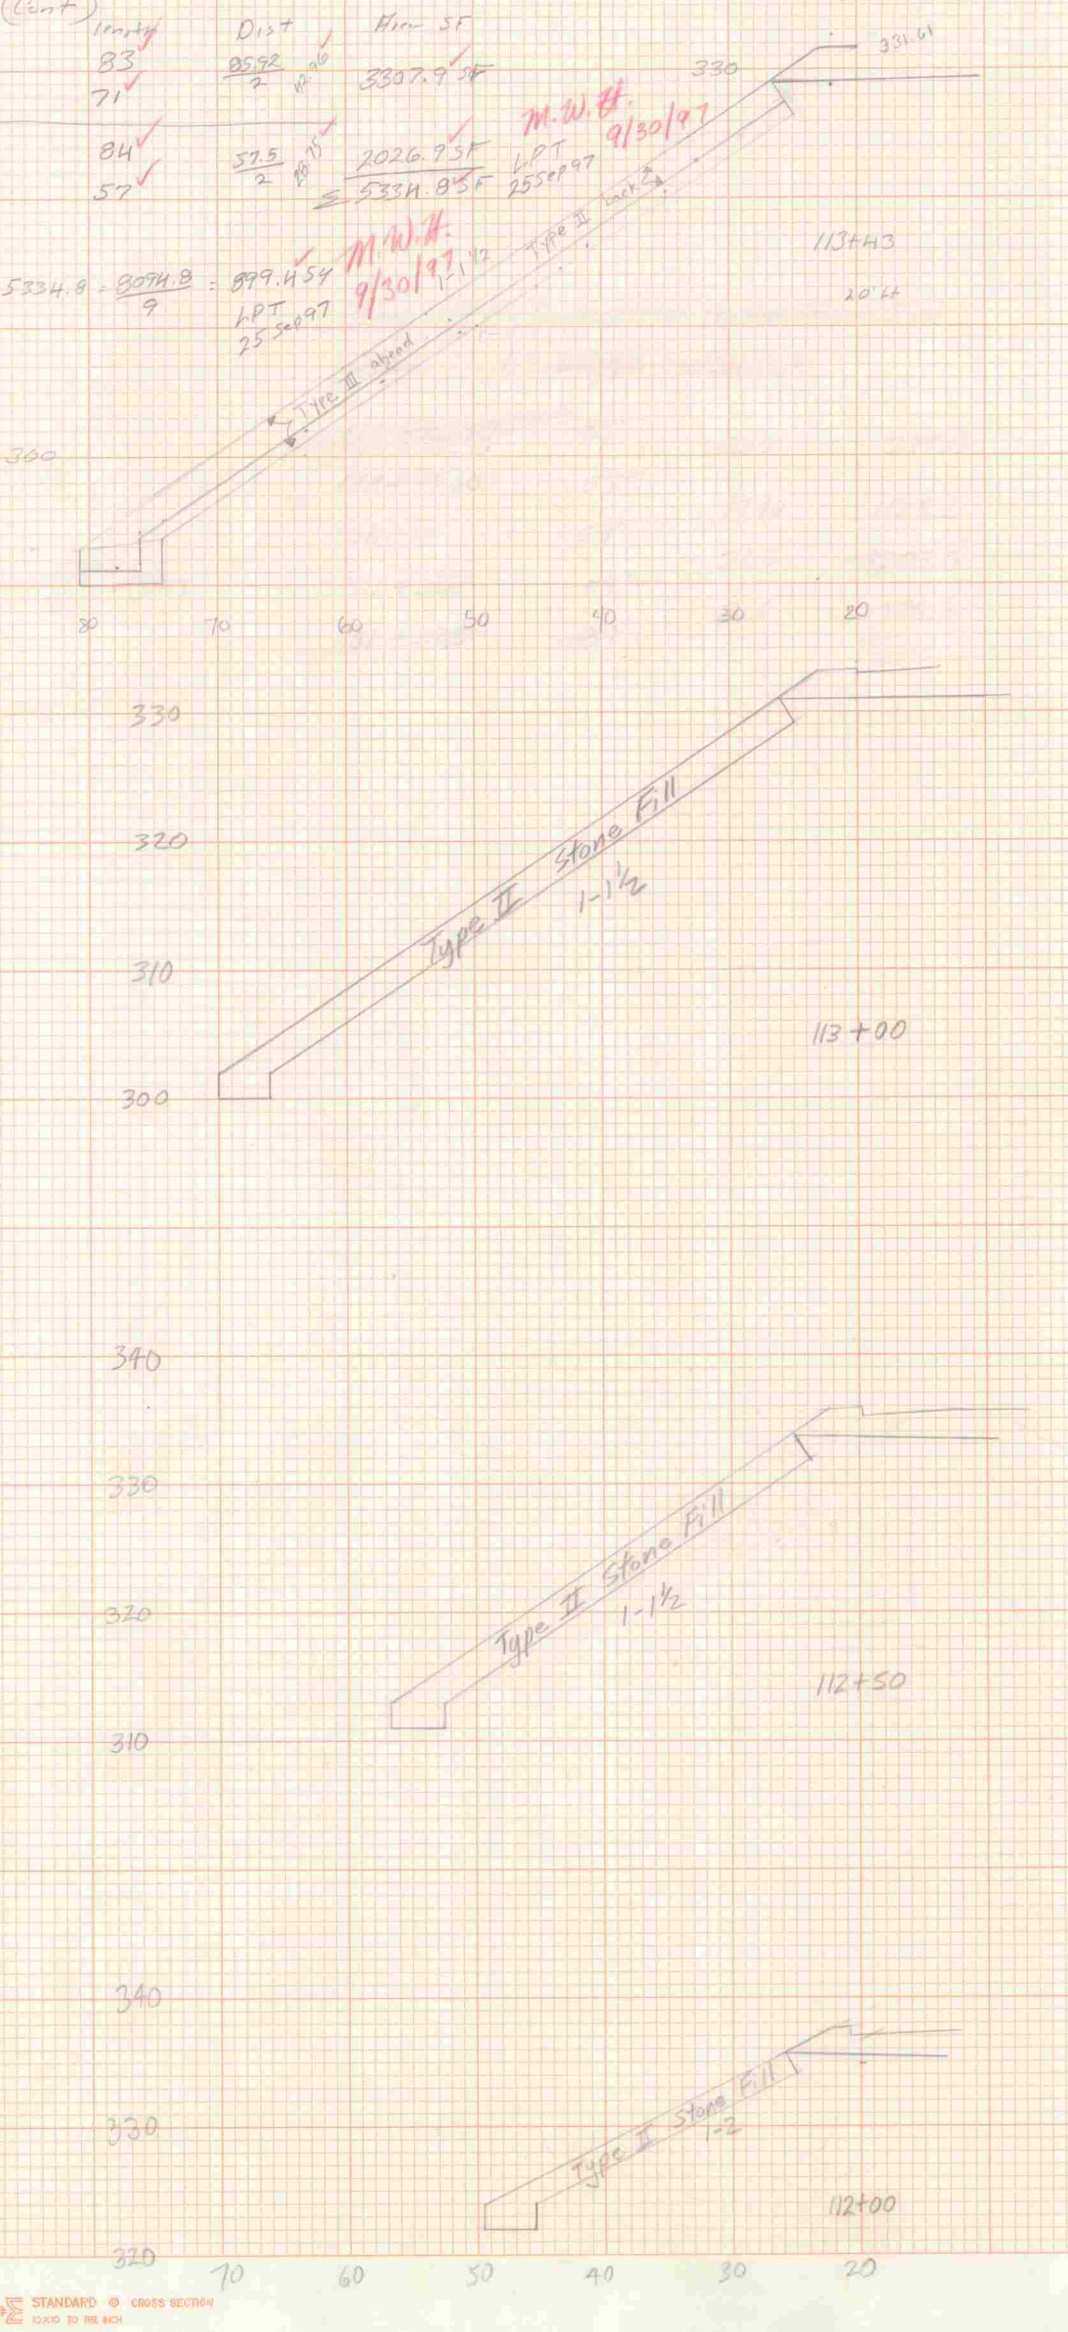
25' Lt Road Pt
331.61
330
Type II Lock 2
1-1½
Type III apron
300
113+43
20' Lt
80
70
60
50
40
30
20
330
320
310
300
Type II Stone Fill
1-1½
113+00
340
330
320
310
Type II Stone Fill
1-1½
112+50
340
330
320
Type II Stone Fill
1-2
112+00
70
60
50
40
30
20

Conn. River End

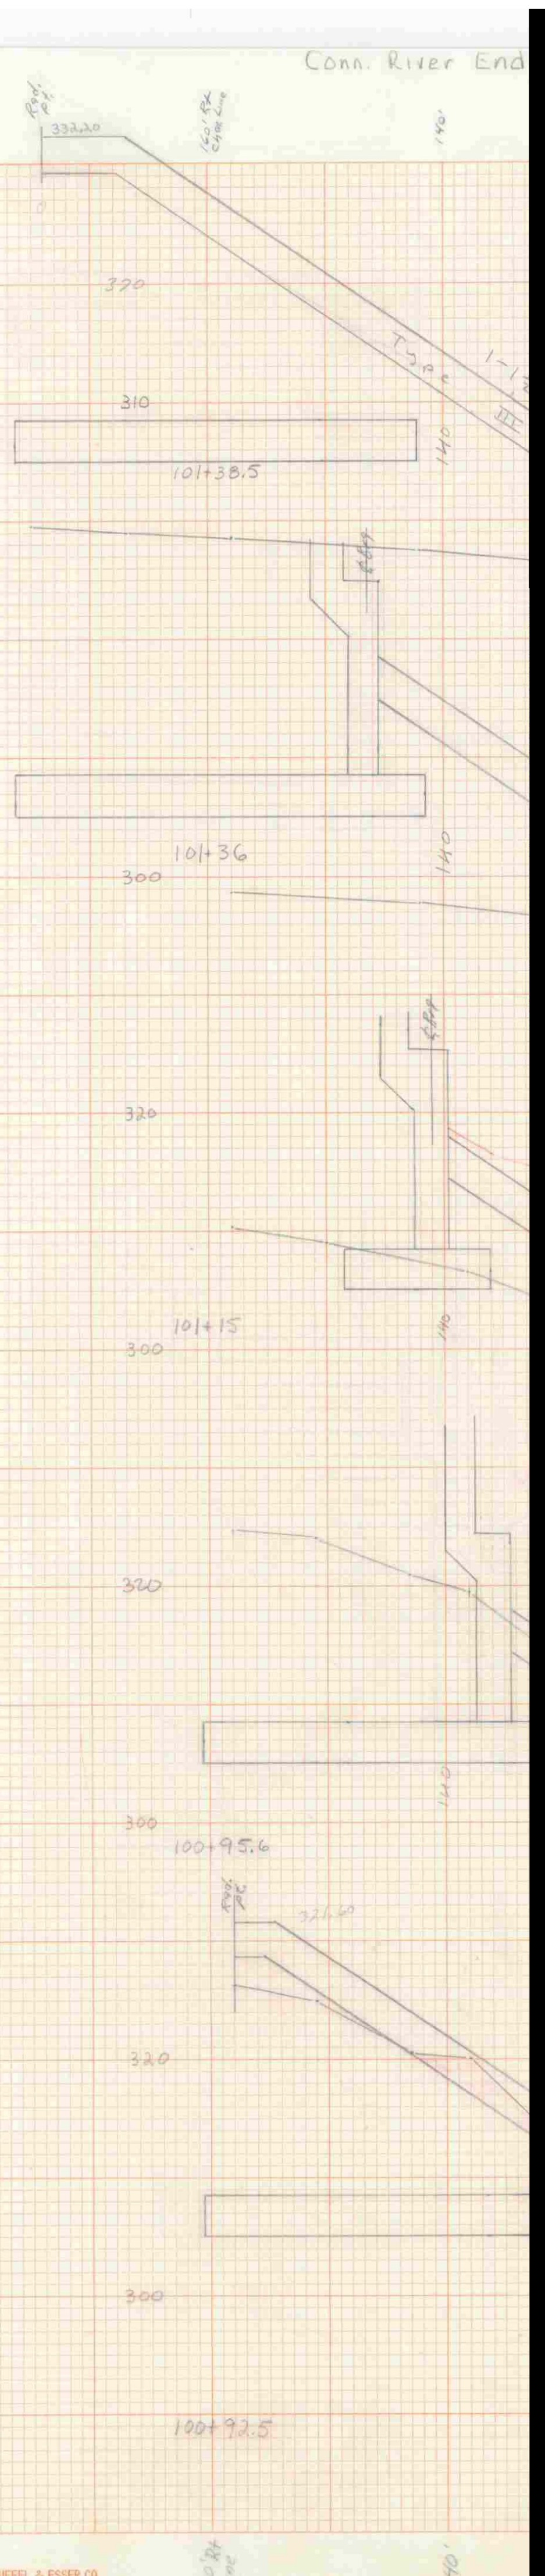
Road Pt
332.20
160' Rt Chan Line
140'
320
310
Type
1-1
III
140
101+38.5
101+36
300
140
320
101+15
300
140
320
300
140
100+95.6
Road Pt
326.60
320
300
100+92.5
160' Rt Chan Line
140'

Old Bridge En

[redacted]

K+E STANDARD CROSS SECTION 10X10 TO THE INCH
KEUFFEL & ESSER CO. MADE IN U.S.A.