Geotextile Under Stone Fill, Item 649.31

Sta.	Length	Sta. Dist.	
Butt 116+50	61	$\frac{41.17}{2}$ 20.58	1255.4
100+92.5	61		
		2.5	132.5
100+95	45		
		20	910.0
101+15	46		
		21	945.0
101+36	44		
		2.5	132.5
101+38.5	62		
		$\frac{64.60}{2}$ 32.30	1905.7
116+50	56		

Total = 5281.1SF = 586.8 SY LPT 25Sep97

M.W.H. 9/30

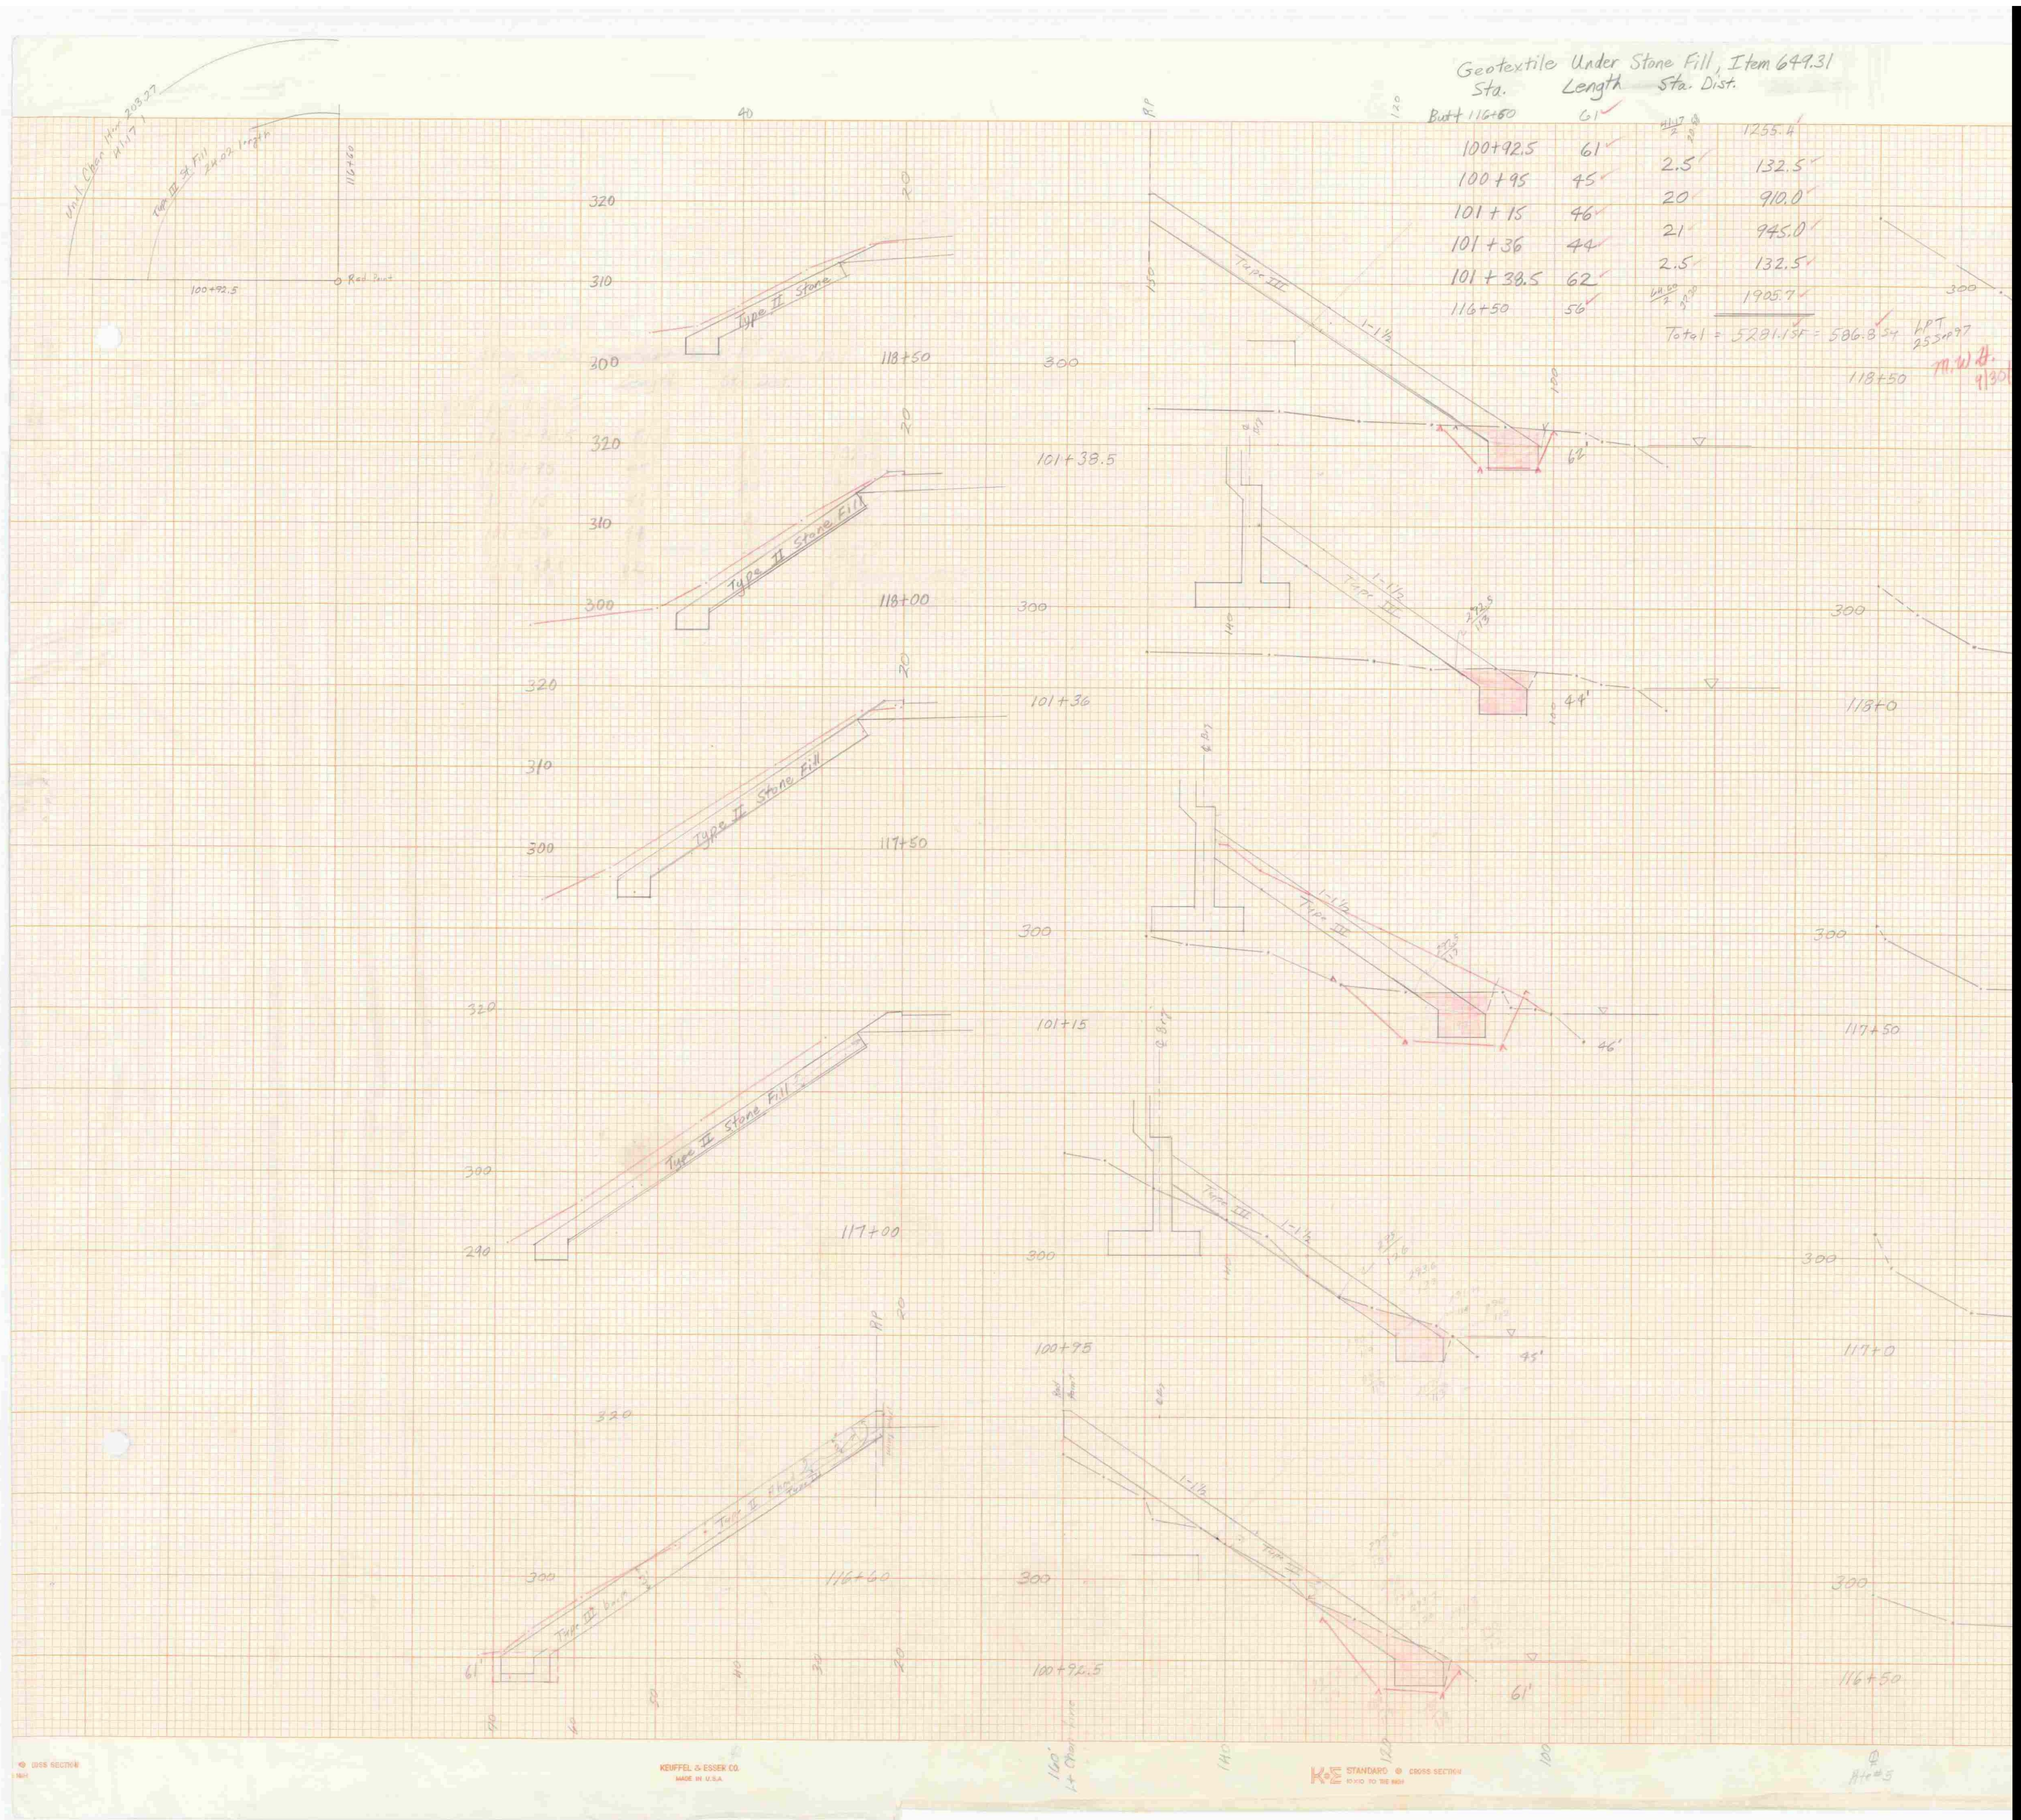

Att #5