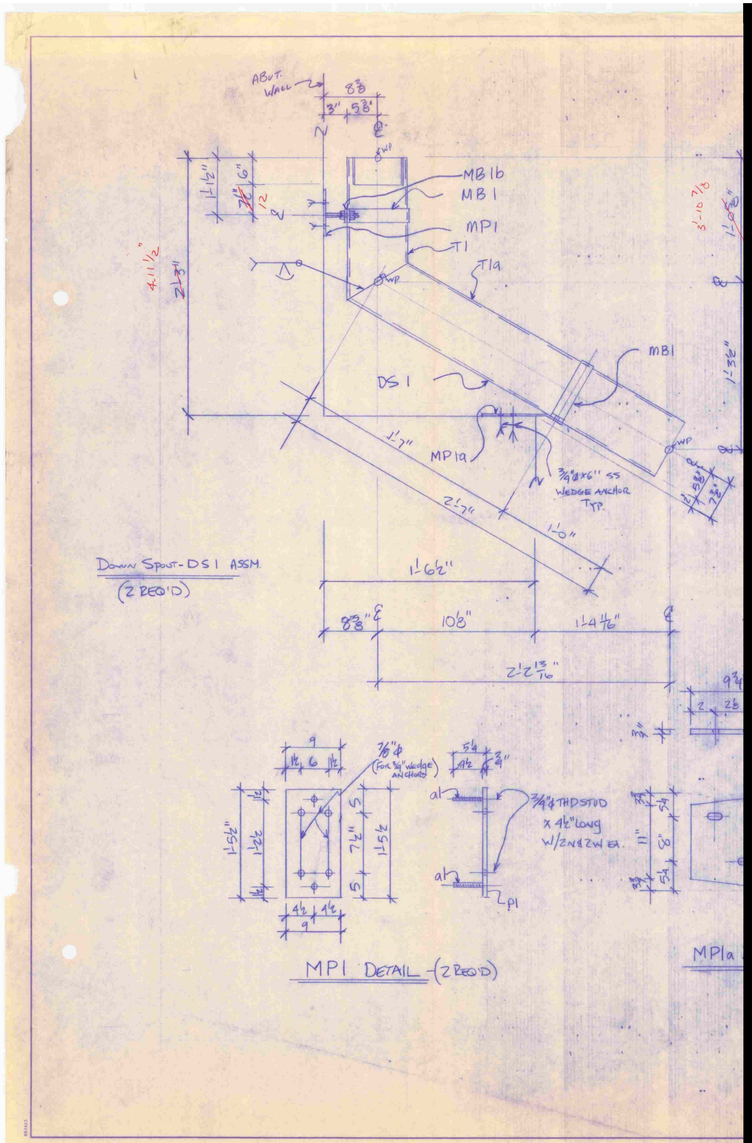
ABUT. WALL
MB1b
MB1
MP1
T1
T1a
MB1
DS1
MP1a
WP
3/4"ø x 6" SS WEDGE ANCHOR TYP.
Down Spout - DS1 ASSM. (2 REQ'D)
3/8"ø (for 3/4" wedge anchors)
3/4"ø THDSTUD x 4½" long w/2 NUTS & 2 WASHERS EA.
PL
MP1 DETAIL - (2 REQ'D)
MP1a