


ORIGINAL SURVEY	SURVEYED	BY	DATE
	PLOTTED		
	TEMPLATE		
	AREAS		
	AREAS CHECKED		
NO.			

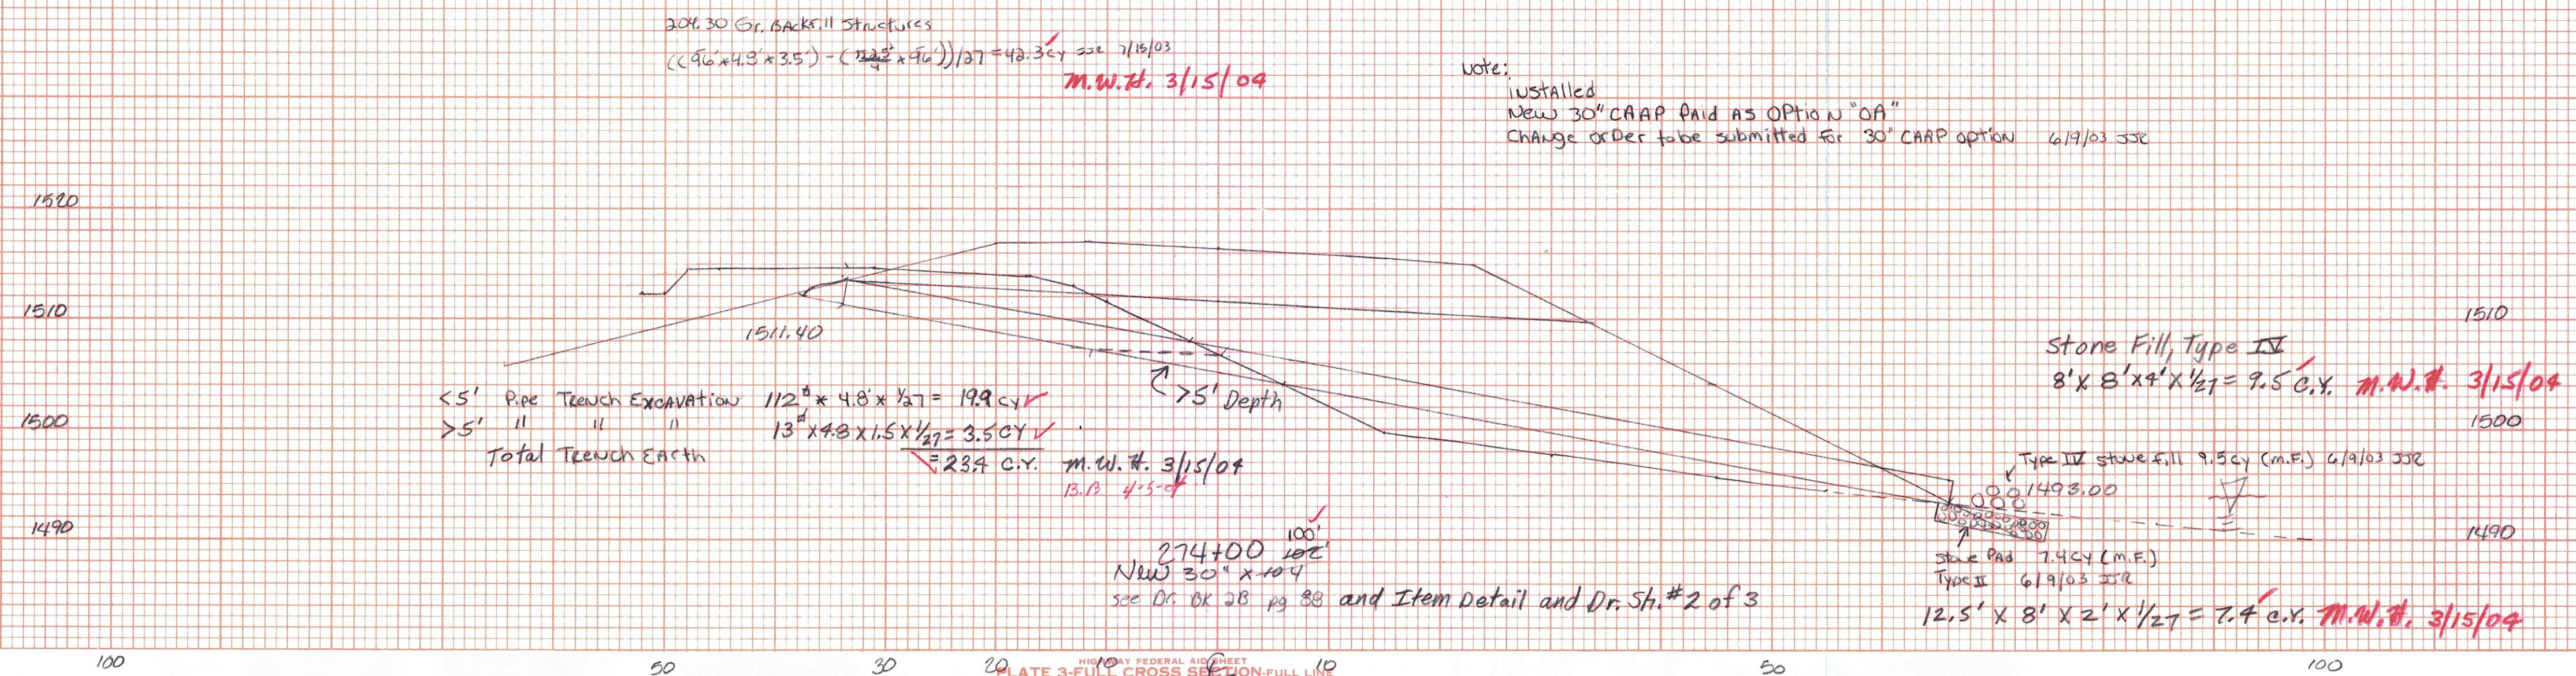

Searsburg - Wilmington
Drainage sheet 21 of 27
New 30" 274+00

SEARSBURG - WILMINGTON
NH-F010-1(18)