BRIDGE 25B
PIER #1

SEARSBURG - WILMINGTON
NH-F010-1(18)

SCALE 1:5

XBR25B-60

FINAL SURVEY
NOTE BOOK
NO.
SURVEYED
PLOTTED
TRACED
AREAS
AREAS CHECKED
BY
DATE

ORIGINAL SURVEY
NOTE BOOK
NO.
SURVEYED
PLOTTED
TRACED
AREAS
AREAS CHECKED
BY
DATE

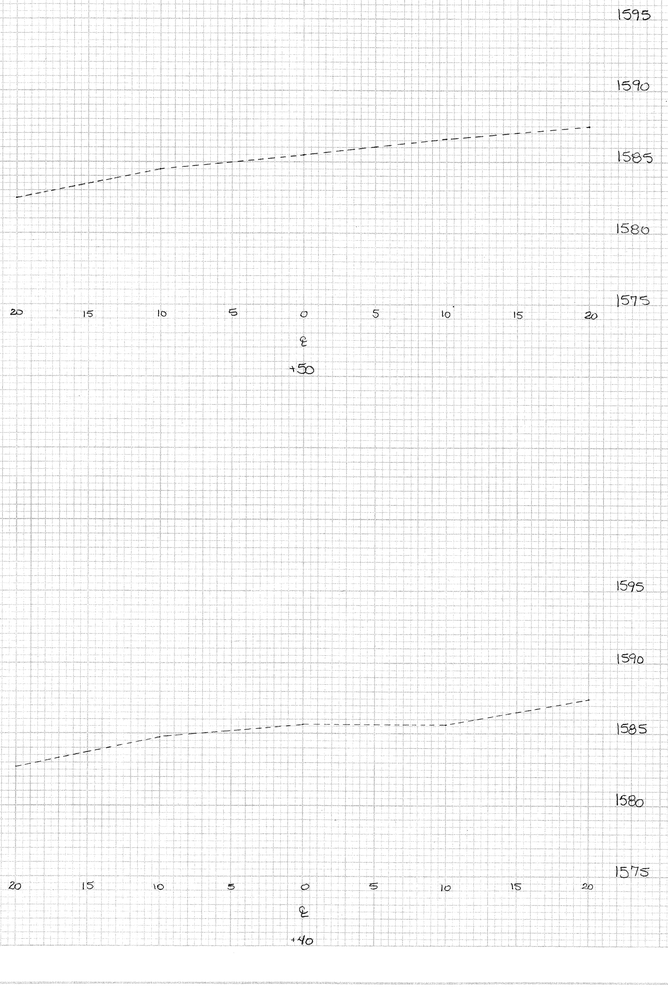

HIGHWAY FEDERAL AID SHEET
PLATE 3-FULL CROSS SECTION-FULL LINE
AMERICAN FORTYPRINT
PRINTED IN U.S.A.

465 BRZ5B P1