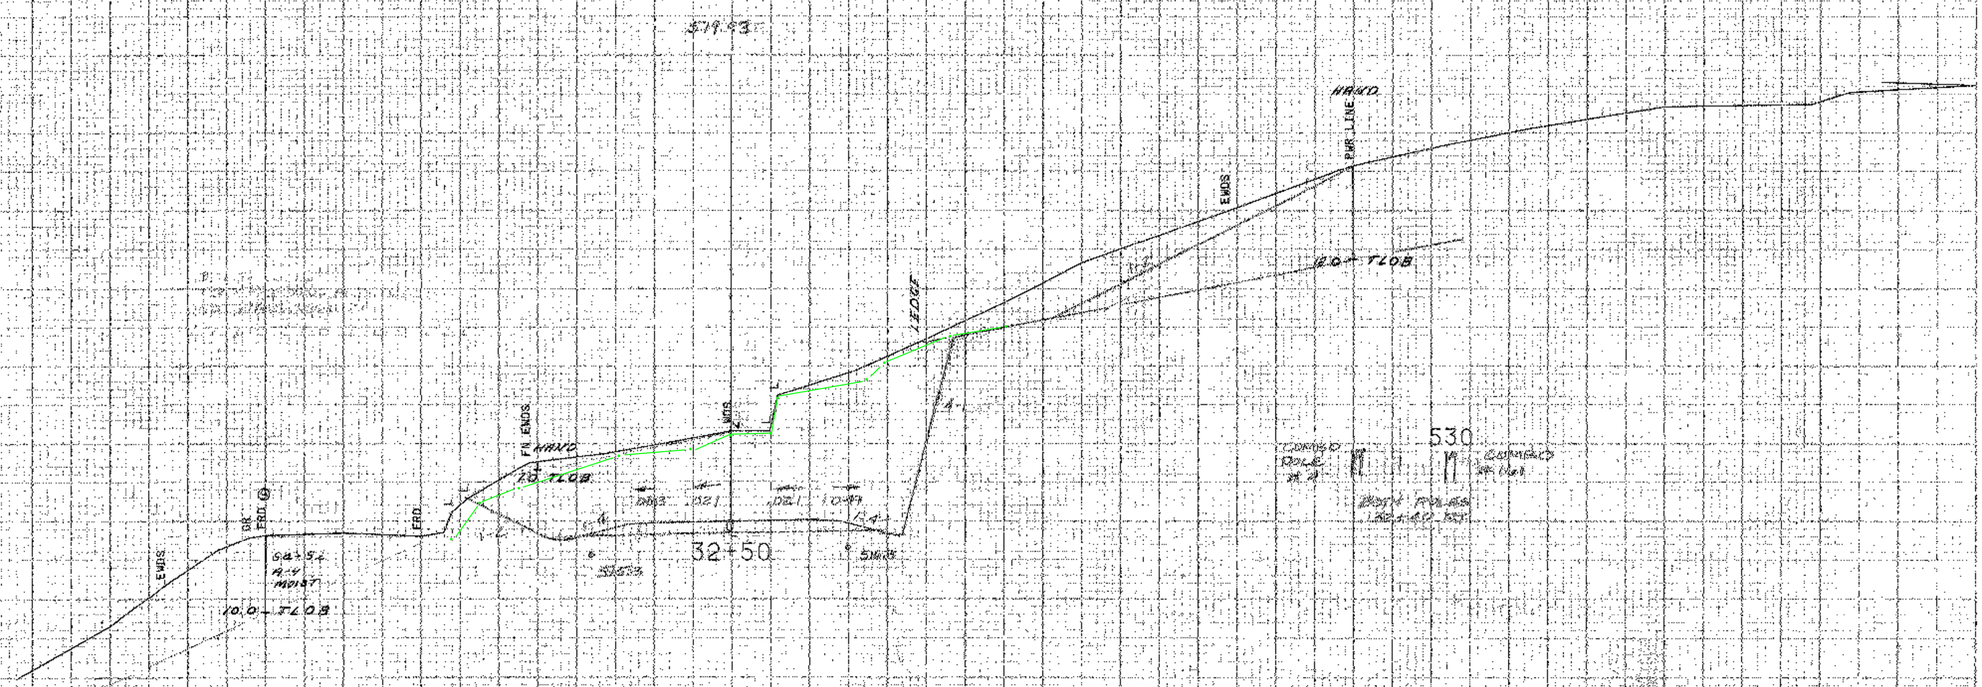

FROM STA. 32+50 TO STA. 32+50
PROJECT NAME MORETOWN MIDDLESEX TH2
NO. RSOT67(9) PLOTTED 06/09/86
SURVEYED BY NYE JAN 1985
SHEET 12 OF 240 SHEETS

SCALE 10 FEET