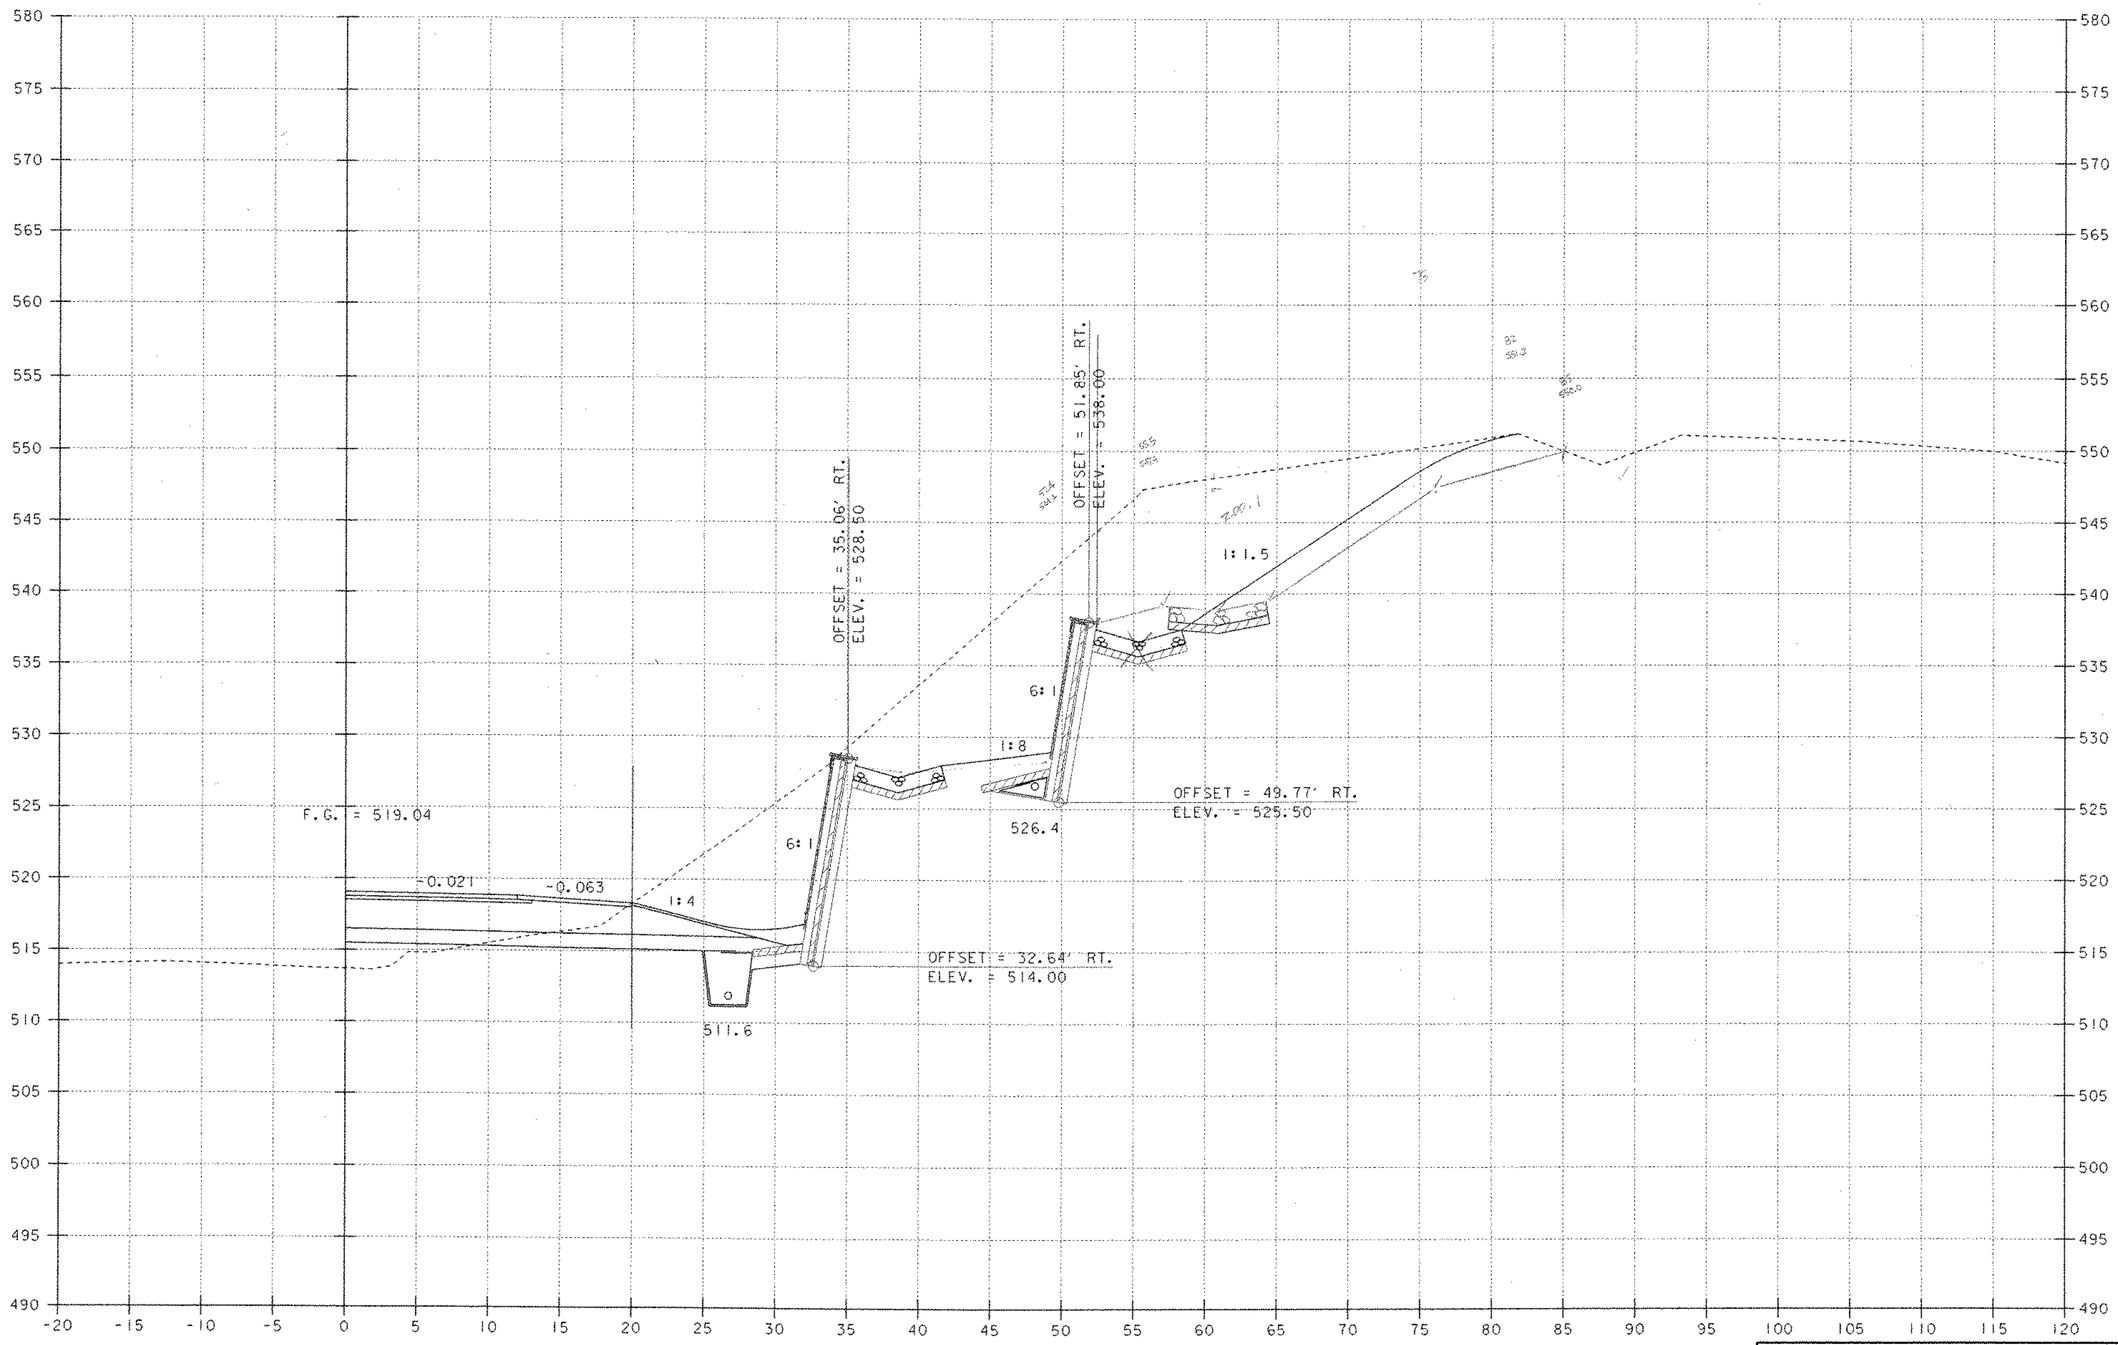


REV. 198+00

SCALE 1" = 5'-0

| | |
|---|---|
| PROJECT NAME: MORETOWN | |
| PROJECT NUMBER: STP EGC RSEGC 0167 (9) | |
| FILE NAME: \78el32\Structures\sel32t20.i | PLOT DATE: 12-MAY-2000 |
| PROJECT LEADER: R. R. WHITCOMB | DRAWN BY: G. ROY |
| DESIGNED BY: C. ALLEN | CHECKED BY: C. ALLEN |
| BRIDGE SHEET BR335 | SHEET 145T OF 243 |