


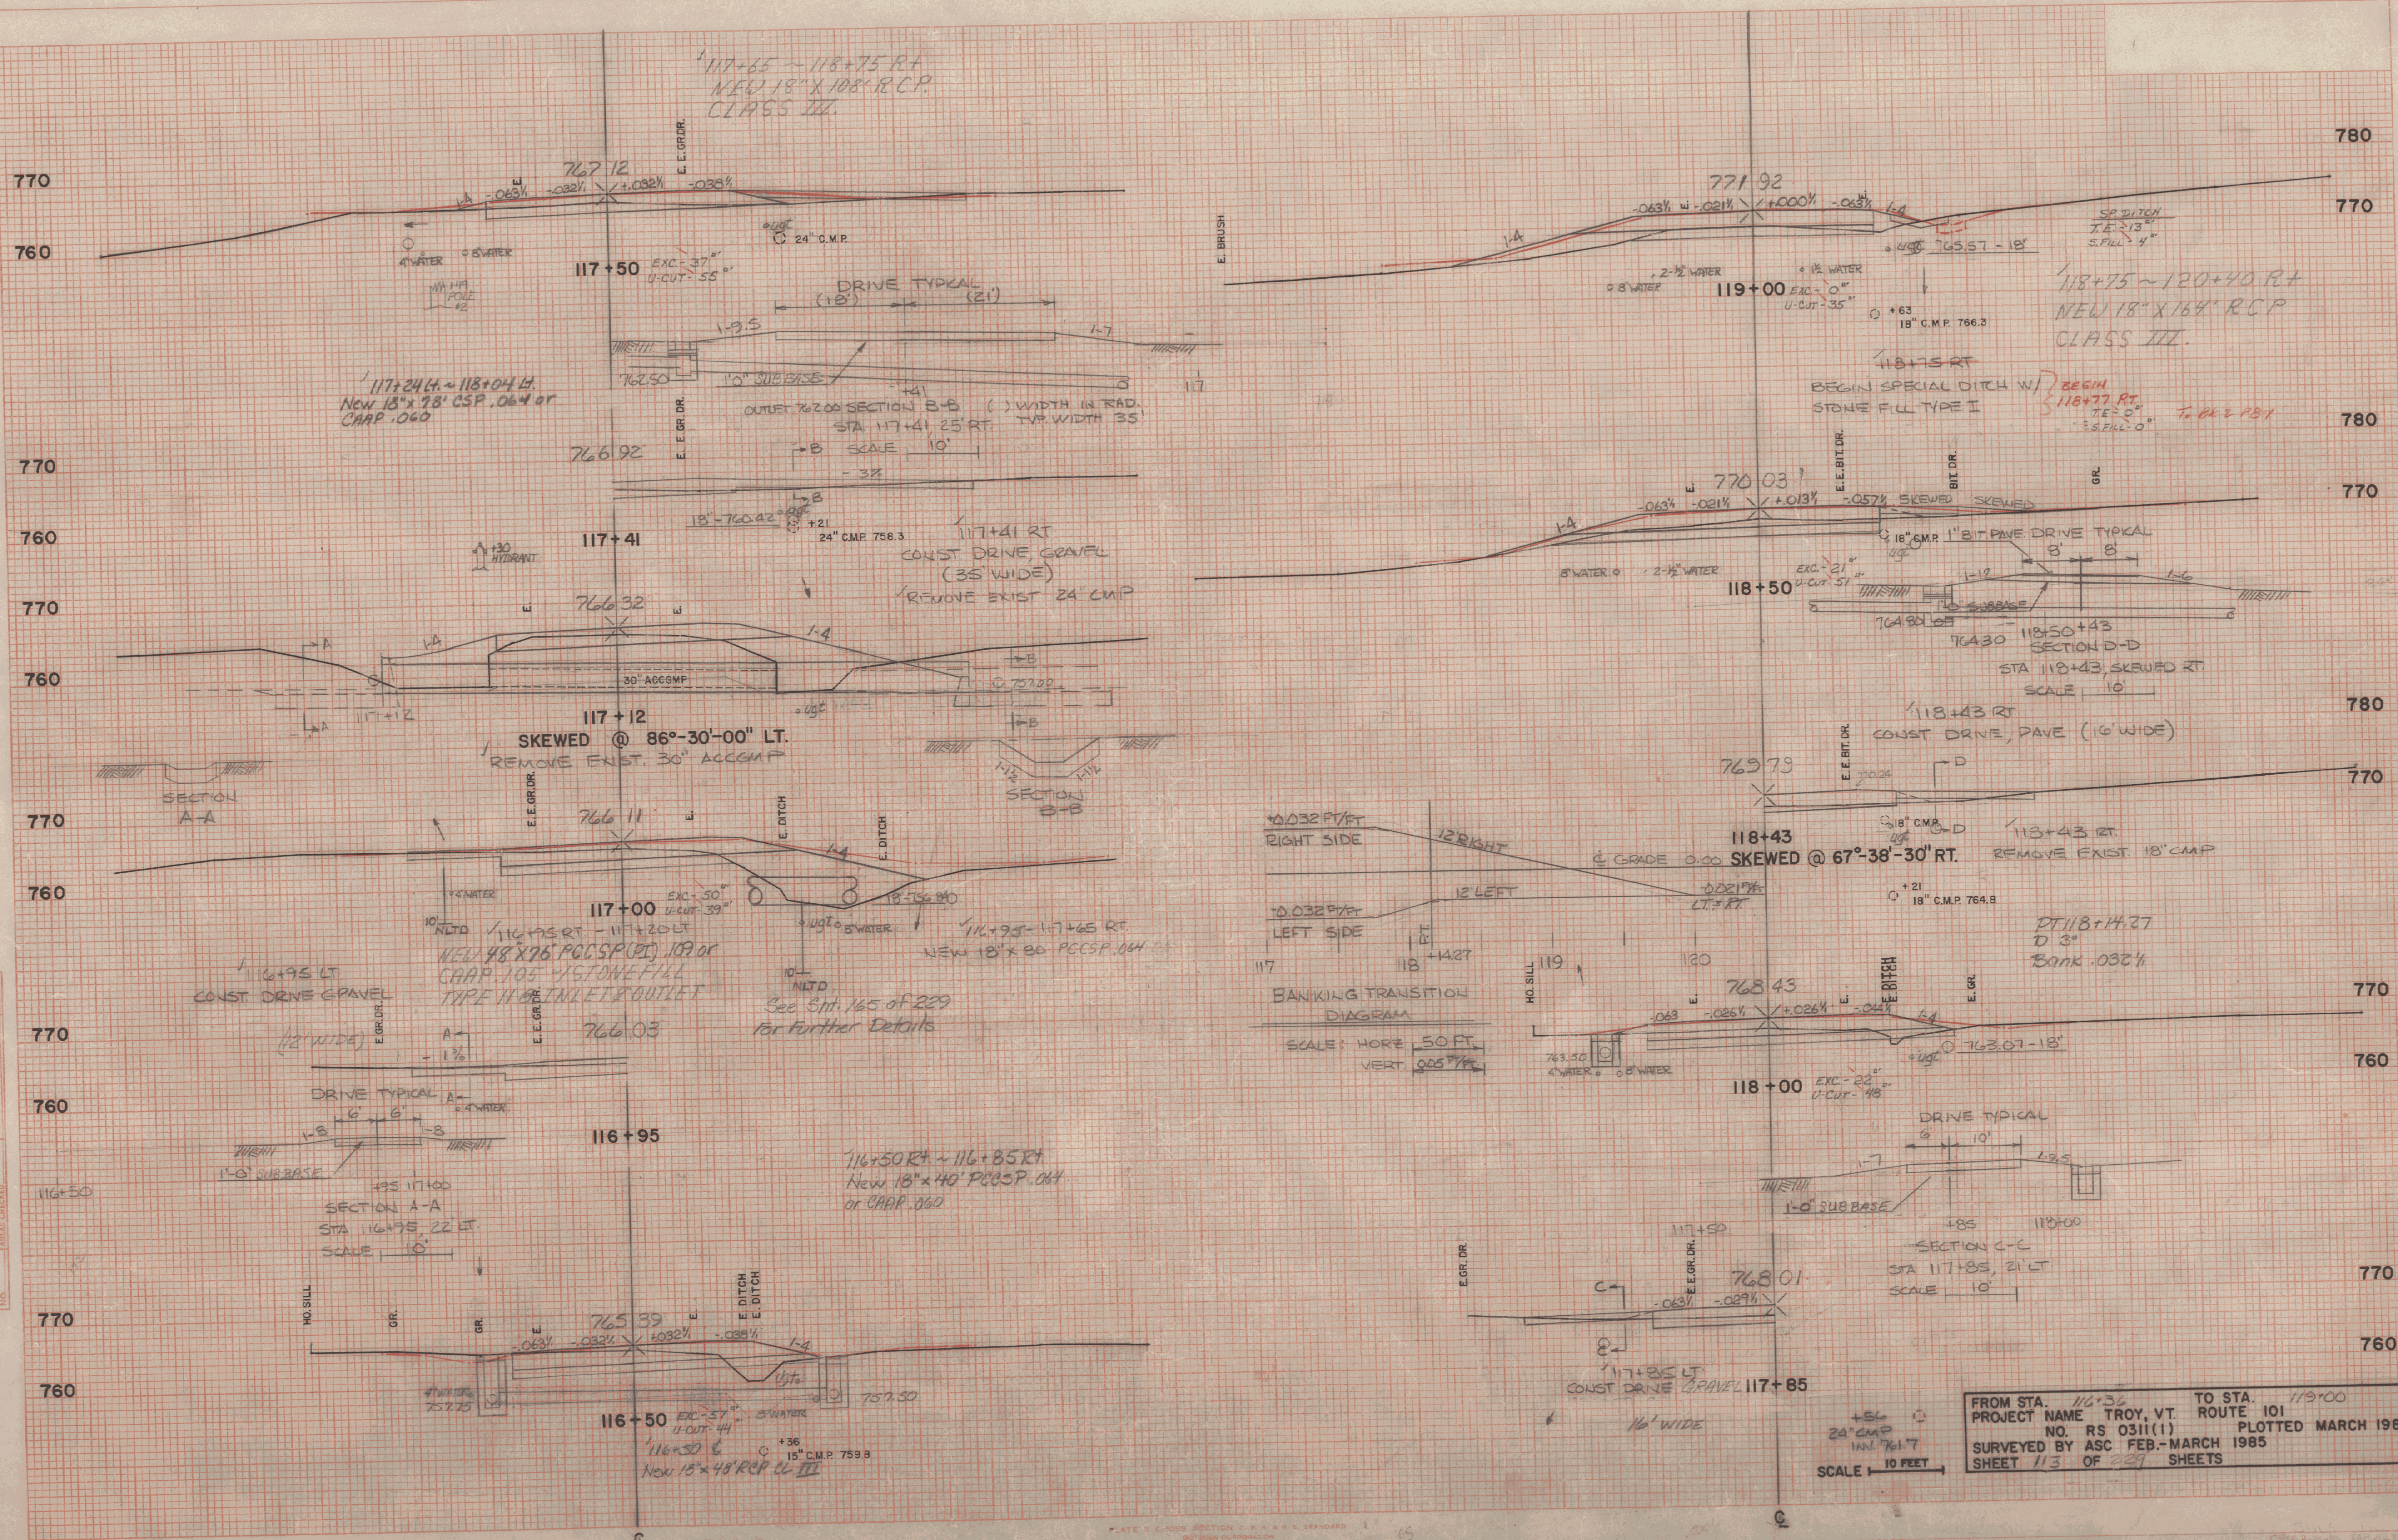

PLOTTED 11-25-91 LEM
PLANIMETERED 1-7-92 LEM