


NO.	SPRS CHECKED	DATE
ORIGINAL	SURVEYED	BY
SURVEY	PLOTTED	
NOTE BOOK	TEMPLATE	
AREAS		

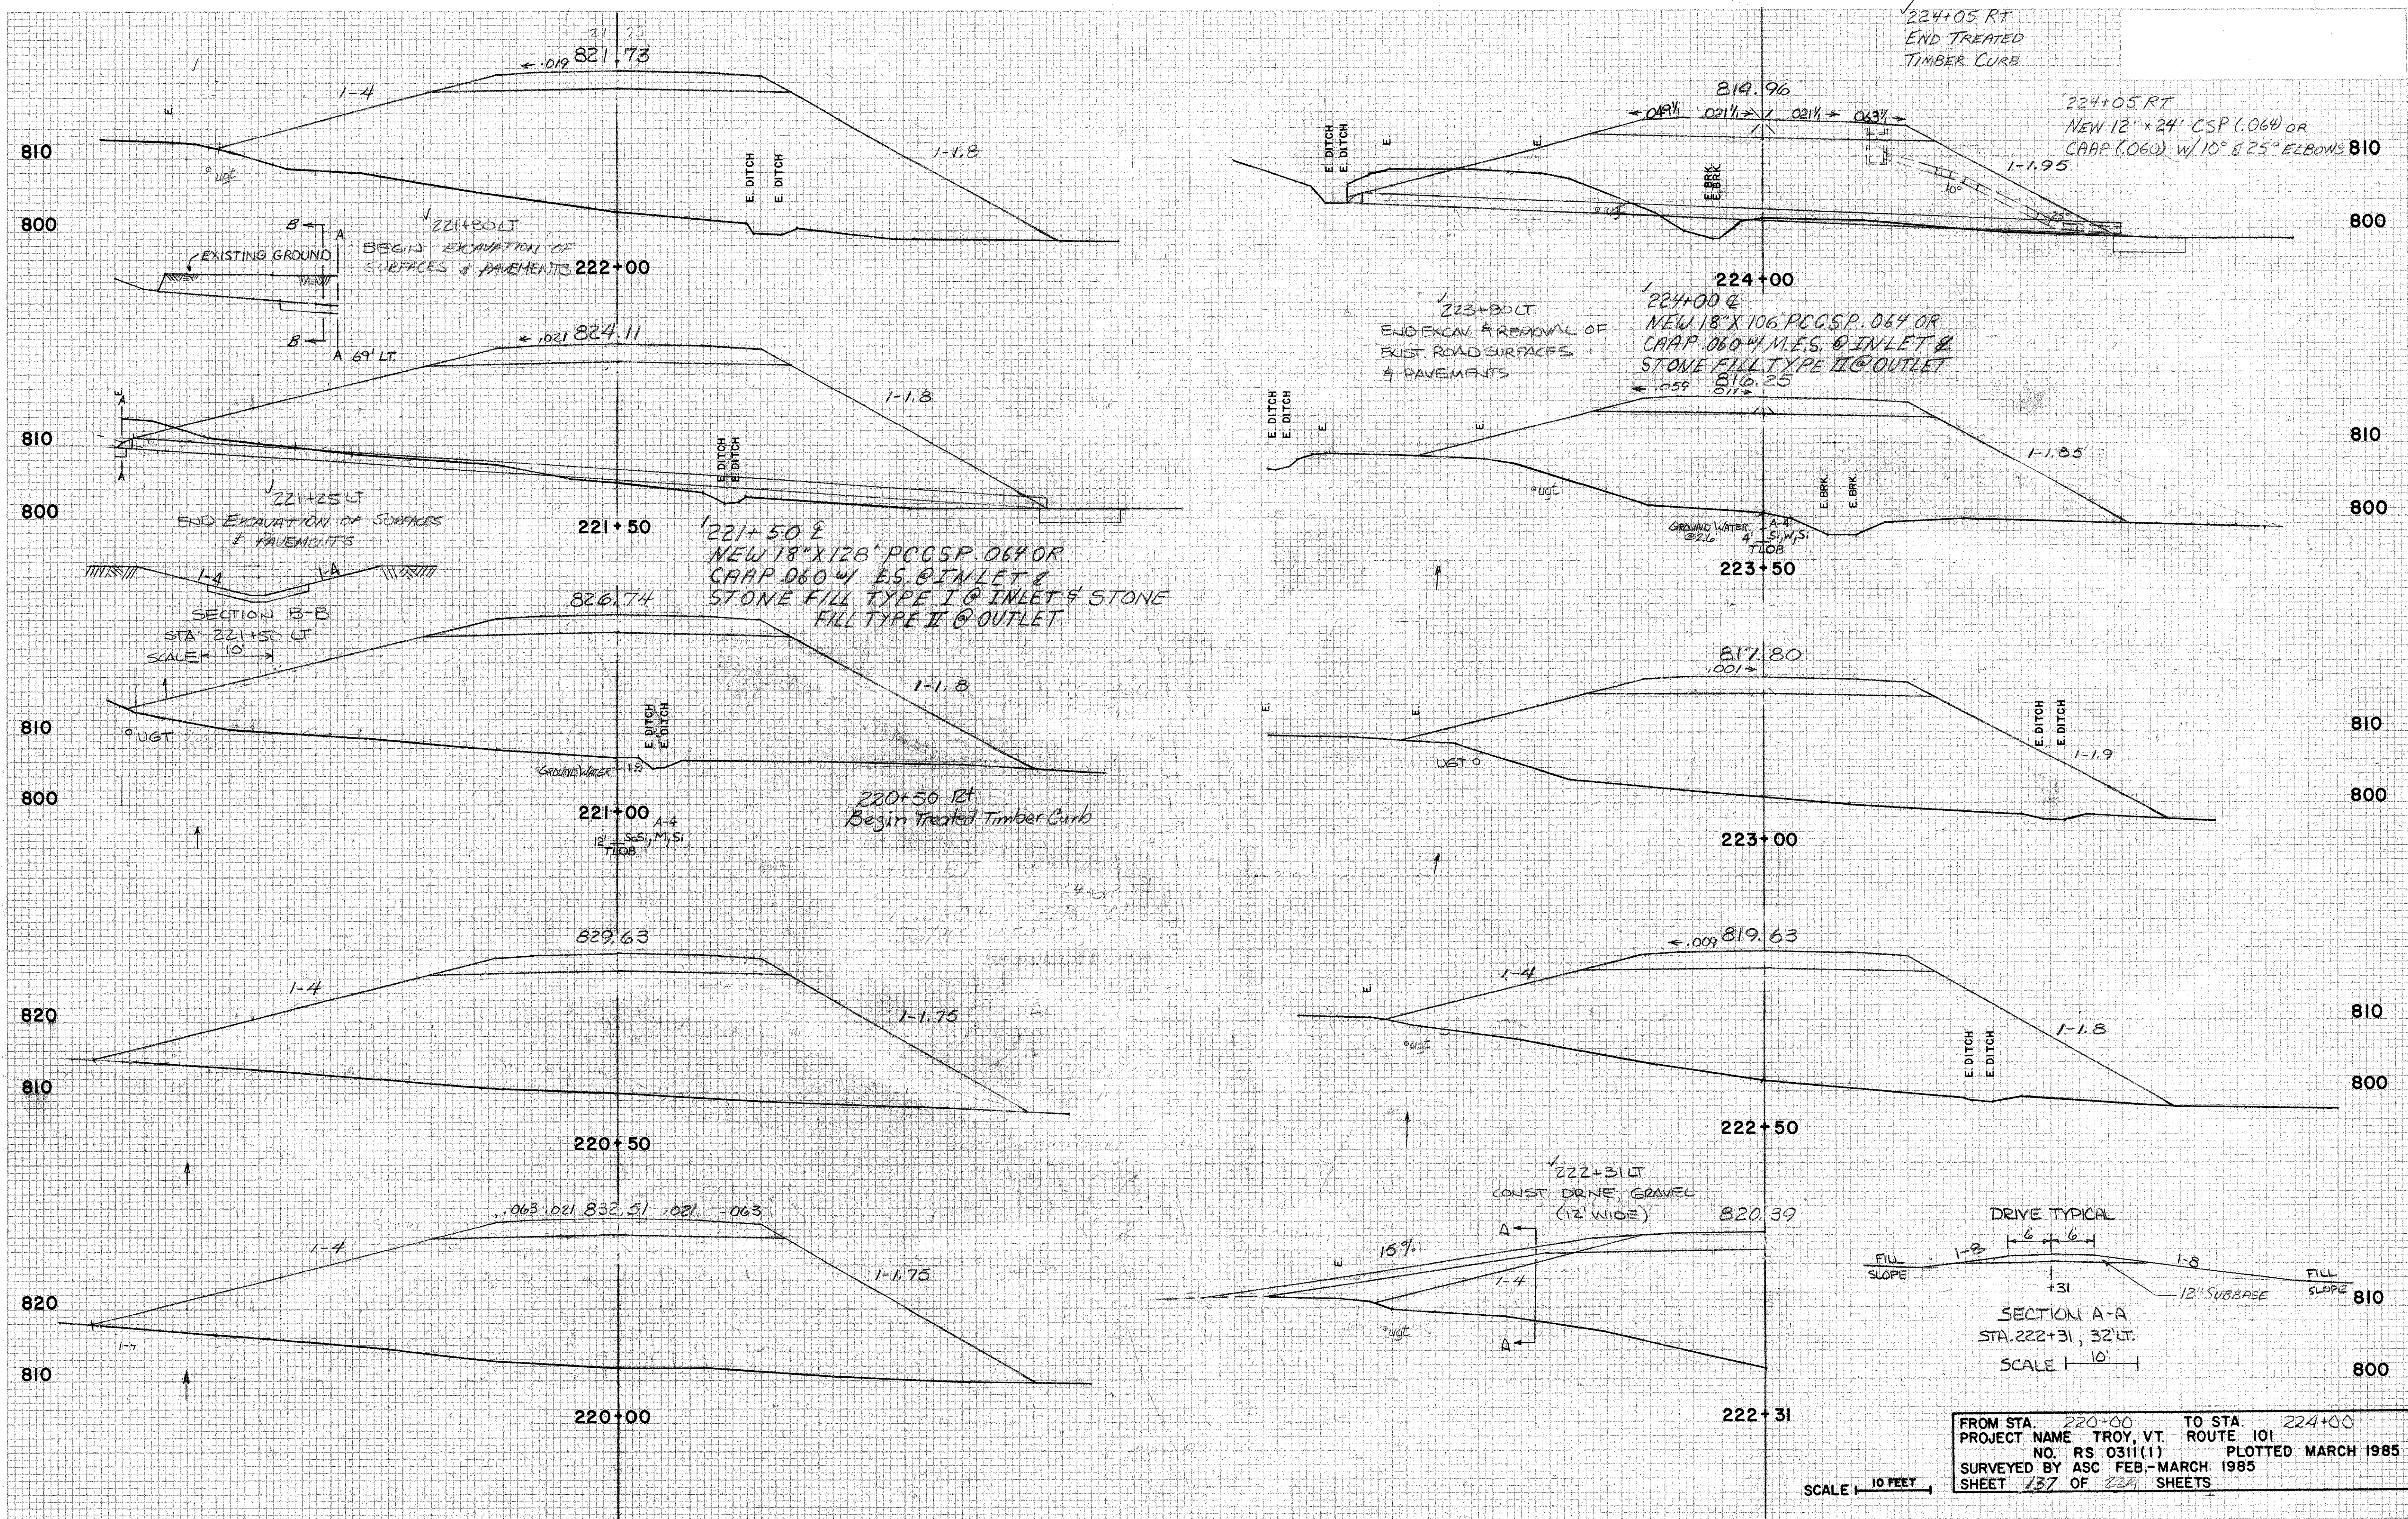


