Removing & Resetting Fence
~~342+45 Lt ~ 352+65 Lt~~

Temporary Barbed Wire Fence (4 Strand)
342+45 Lt. ~ ~~352+65 Lt~~
70 353+13

CONSTRUCT APPROACH
342+25 LT TH #27

REMOVAL OF EXISTING FENCE
LT RT
~~342+45 ~ 352+65~~
(NON-PART.)

RELOCATE MAILBOX, SINGLE SUPPORT
342+50 Lt.

STEEL BEAM GUARD RAIL

LT. RT.
343+00 ~ 349+00 342+10 ~ ~~347+60~~ 347.5

BREAKAWAY CABLE TERMINAL

LT. RT.
342+75 ~ ~~343+00~~ 341+85 ~ 342+10
349+00 ~ 349+25 ~~347+60~~ ~ ~~347+85~~
347.5 348+22.5

REMOVAL AND DISPOSAL OF GUARD RAIL


LT. RT.
~~343+51~~ ~ ~~348+81~~ 343+23 ~ 347+91
45 47

GEOTEXTILE FABRIC FOR SILT FENCE

342+50 LT ~ 348+50 LT 342+50 RT ~ 348+50 RT

CLEARING & GRUBBING

LT. Rt.
343+28 ~ 347+00
(to const. limits)

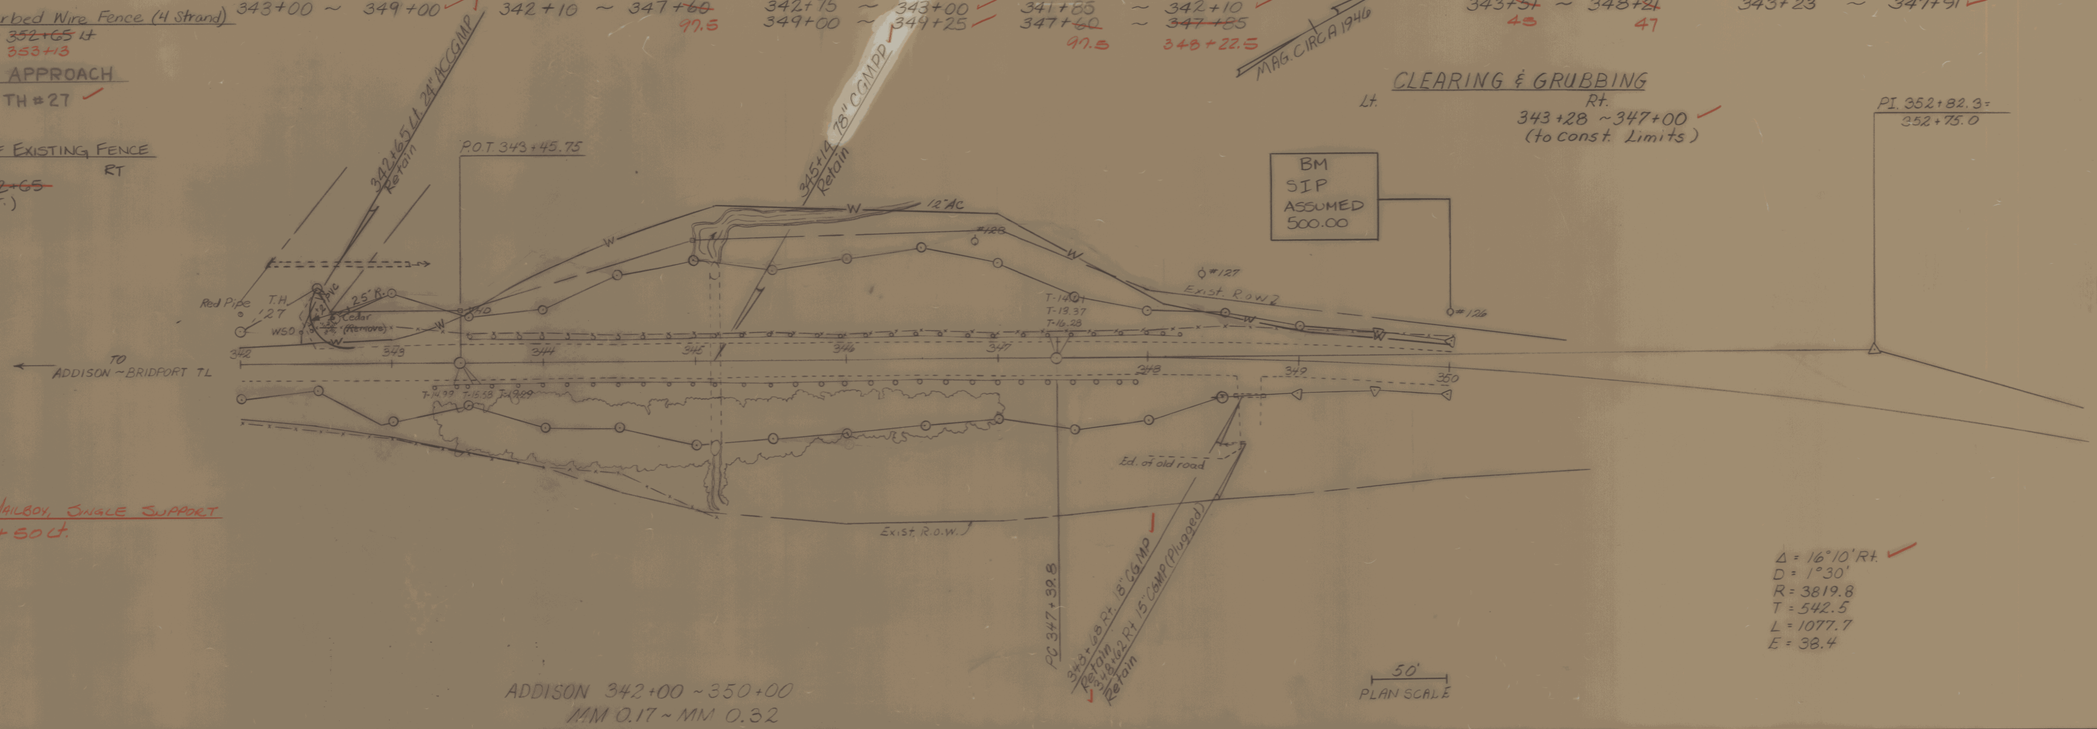

Δ = 16°10' Rt.
D = 1°30'
R = 3819.8
T = 542.5
L = 1077.7
E = 38.4

PLAN SCALE 1" = 50'

ADDISON 342+00 ~ 350+00
MM 0.17 ~ MM 0.32

PROFILE SCALE 1" = 10' H, 1" = 50' V

SHOREHAM BRIDPORT ~ ADDISON
F 017-1(2)
Sheet ~~169~~ 169 of ~~420~~
SHEET 169 OF 477

PLATE 1 SINGLE PLAN - PROFILE
CHARLES BRUNING CO.

BRUNING 44-131 53428