


PARCEL	INSTRUMENT	DATE	GRANTOR	GRANTEE	RECORDED			REMARKS
					BOOK	PAGE	DATE	
A	W.D.O.E.	10-10-46	GEO. H. & HILDA E. GARNEAU	ST. OF VT.	29	259-260	10-19-46	
	W.D.O.E.	10-10-46	LAWRENCE VINCENT	" "	29	263-264	10-19-46	OUTLET DITCH

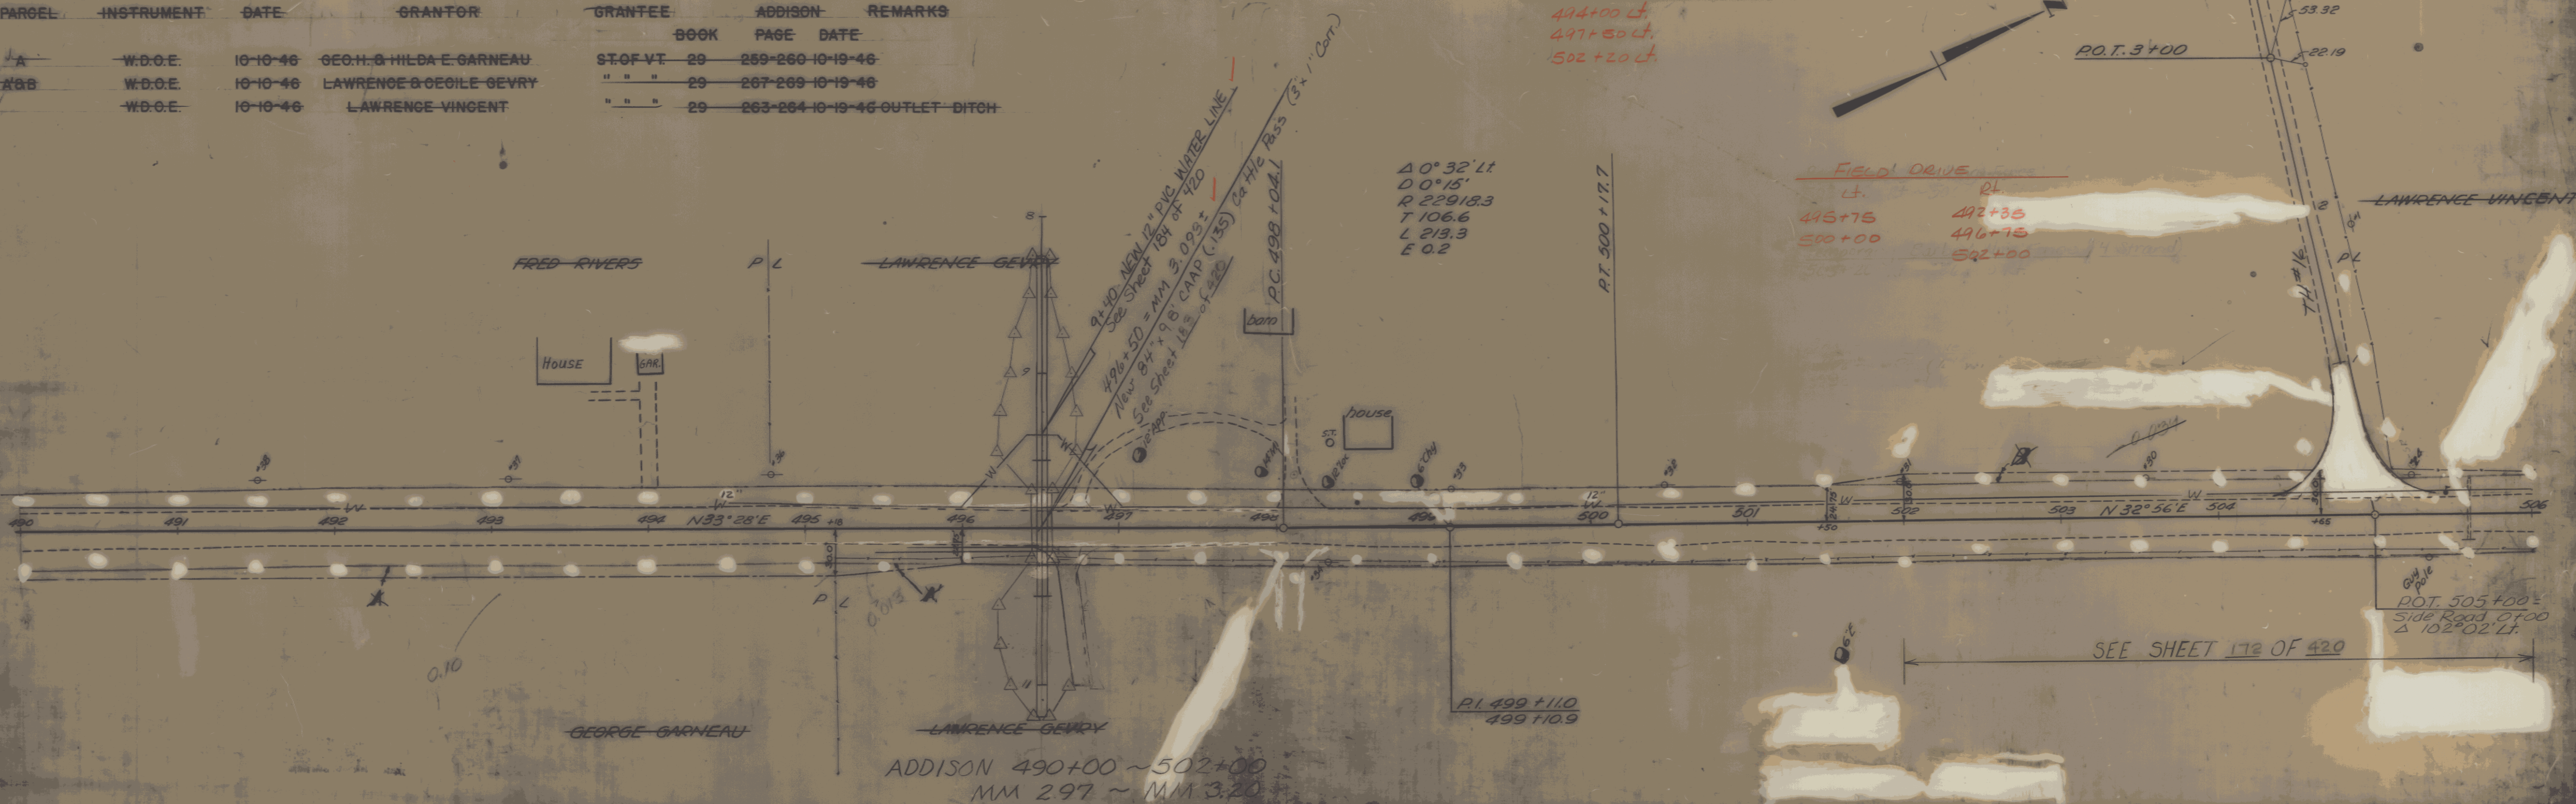

RELOCATE MAILBOX, SINGLE SUPPORT
414+00 LT.
497+50 LT.
502+20 LT.

FIELD DRIVE
LT.
445+75
500+00
492+35
496+75
502+00

SEE SHEET 172 OF 420

