


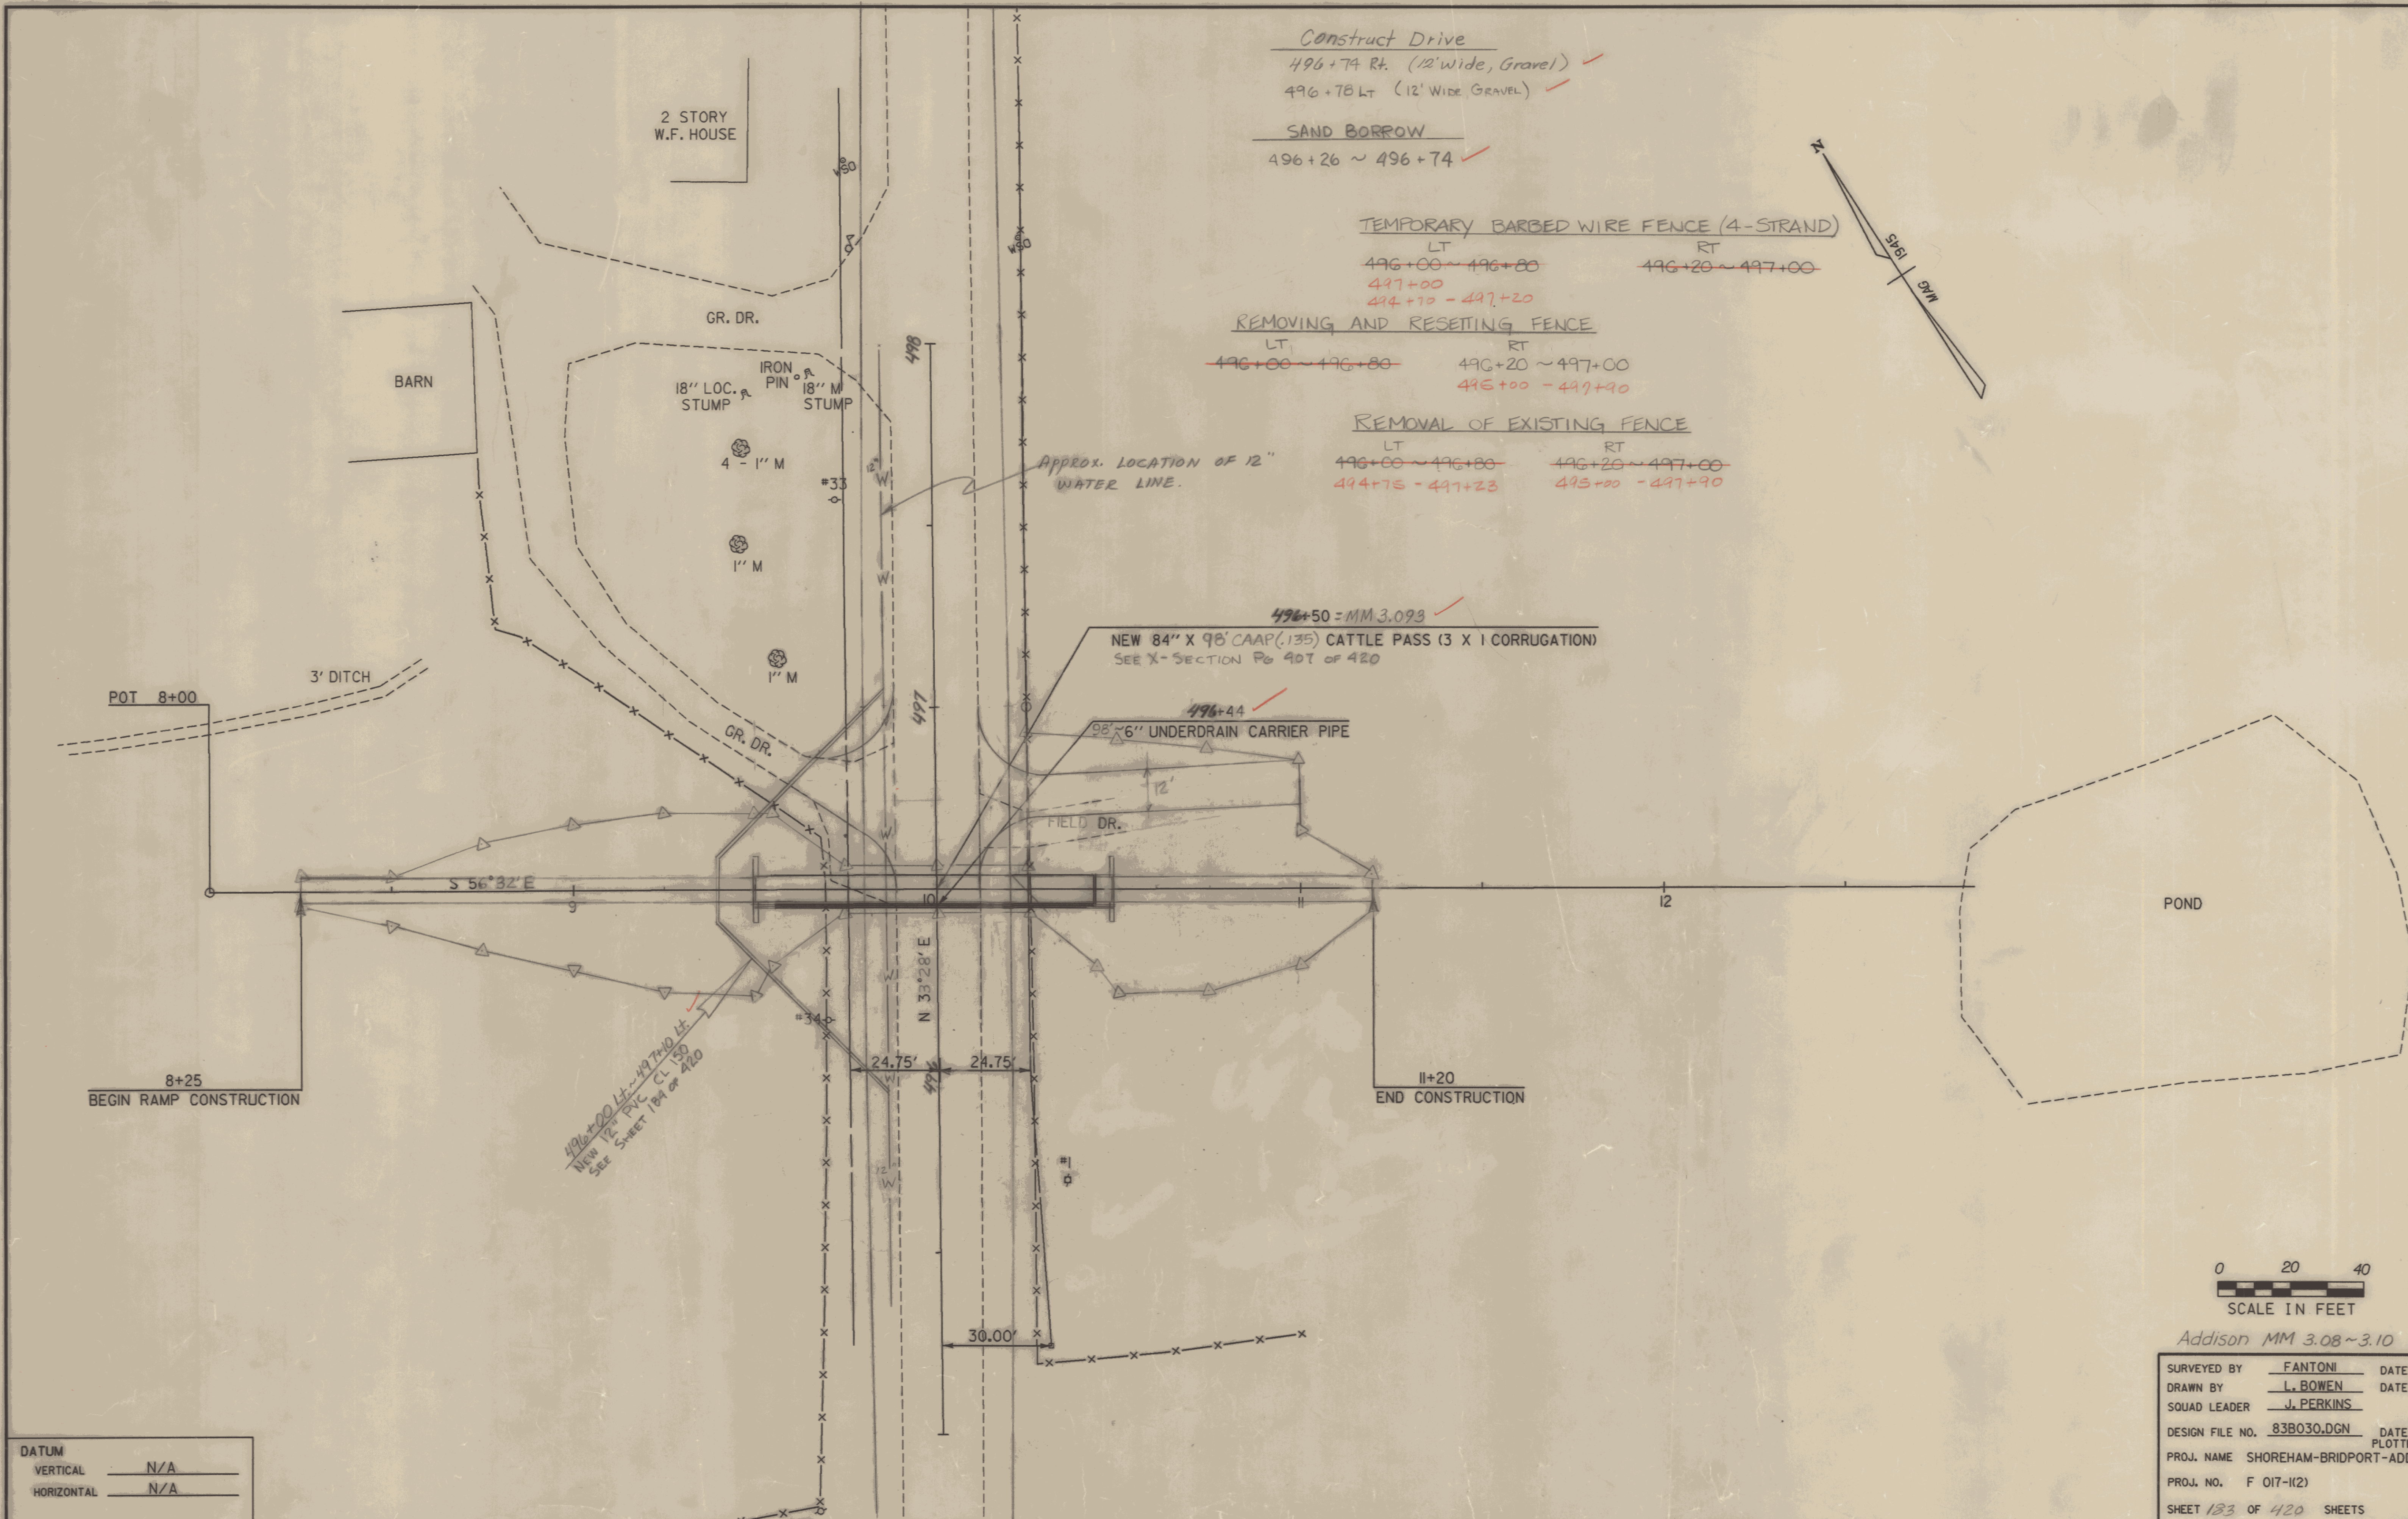

DATUM	
VERTICAL	N/A
HORIZONTAL	N/A

0 20 40	
SCALE IN FEET	
Addison MM 3.08 ~ 3.10	
SURVEYED BY	FANTONI
DATE	10/87
DRAWN BY	L. BOWEN
DATE	5/88
SQUAD LEADER	J. PERKINS
DESIGN FILE NO.	83B030.DGN
DATE	5/23/88
PROJ. NAME	SHOREHAM-BRIDPORT-ADDISON
PROJ. NO.	F 017-1(2)
SHEET 183 OF 420	SHEETS