


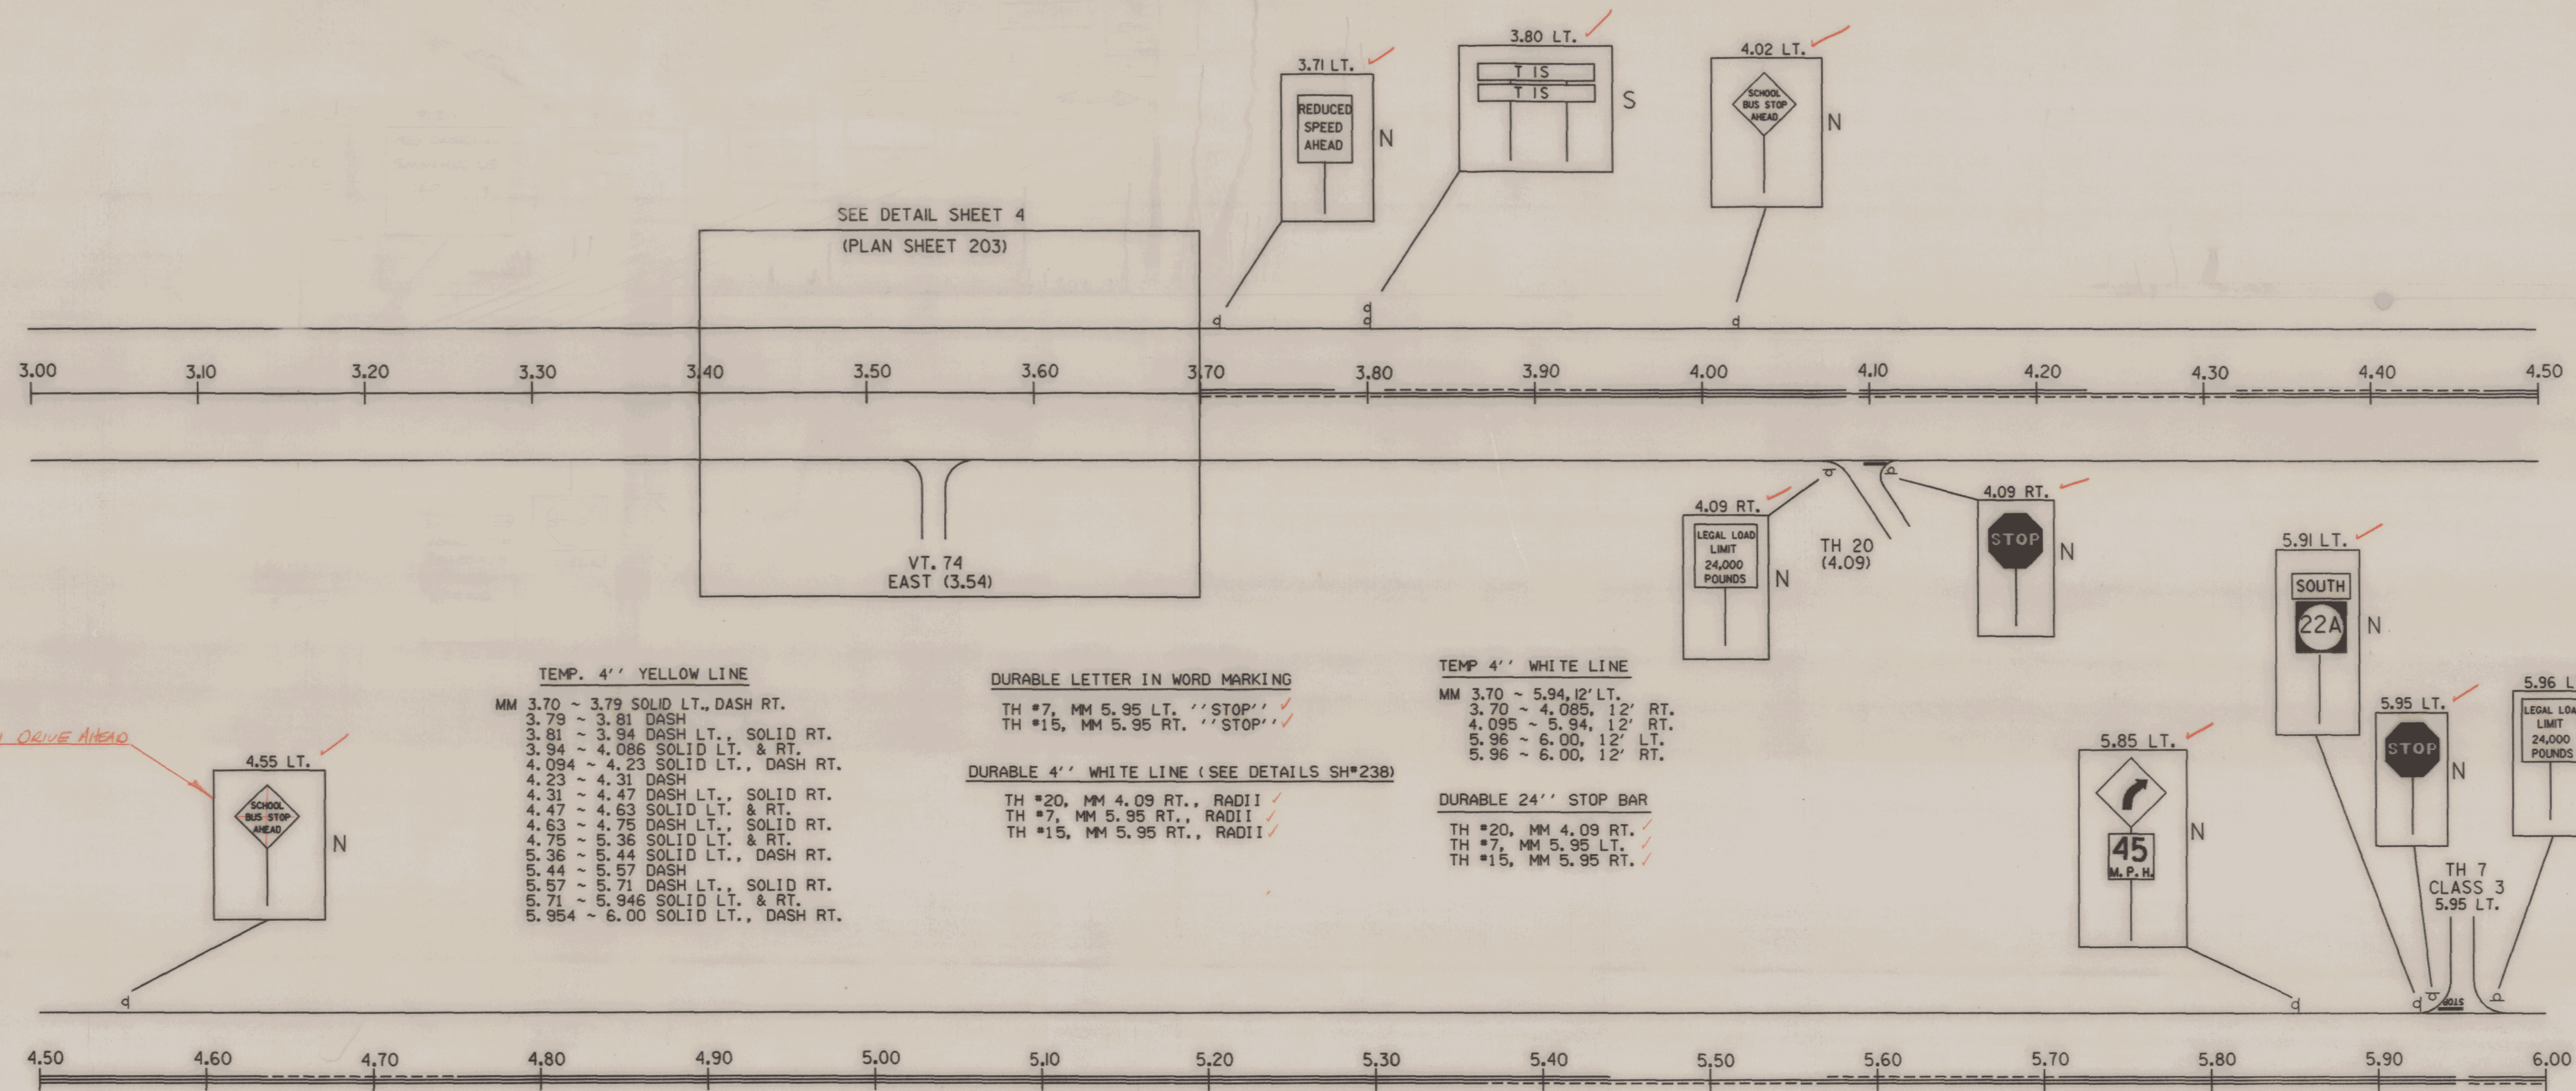

TEMP. 4" YELLOW LINE

MM 3.70 ~ 3.79 SOLID LT., DASH RT.
 3.79 ~ 3.81 DASH
 3.81 ~ 3.94 DASH LT., SOLID RT.
 3.94 ~ 4.086 SOLID LT. & RT.
 4.094 ~ 4.23 SOLID LT., DASH RT.
 4.23 ~ 4.31 DASH
 4.31 ~ 4.47 DASH LT., SOLID RT.
 4.47 ~ 4.63 SOLID LT. & RT.
 4.63 ~ 4.75 DASH LT., SOLID RT.
 4.75 ~ 5.36 SOLID LT. & RT.
 5.36 ~ 5.44 SOLID LT., DASH RT.
 5.44 ~ 5.57 DASH
 5.57 ~ 5.71 DASH LT., SOLID RT.
 5.71 ~ 5.946 SOLID LT. & RT.
 5.954 ~ 6.00 SOLID LT., DASH RT.

DURABLE LETTER IN WORD MARKING

TH #7, MM 5.95 LT. "STOP"
 TH #15, MM 5.95 RT. "STOP"

DURABLE 4" WHITE LINE (SEE DETAILS SH*238)

TH #20, MM 4.09 RT., RADII
 TH #7, MM 5.95 RT., RADII
 TH #15, MM 5.95 RT., RADII

TEMP 4" WHITE LINE

MM 3.70 ~ 5.94, 12' LT.
 3.70 ~ 4.085, 12' RT.
 4.095 ~ 5.94, 12' RT.
 5.96 ~ 6.00, 12' LT.
 5.96 ~ 6.00, 12' RT.

DURABLE 24" STOP BAR

TH #20, MM 4.09 RT.
 TH #7, MM 5.95 LT.
 TH #15, MM 5.95 RT.


NEW SIGN LEGEND

LOCATION	
SCHOOL BUS STOP AHEAD	
N	= NEW
S	= SALVAGE
RET	= RETAIN
NEW SIGN	

DATUM

VERTICAL NGVD 1929

HORIZONTAL N/A

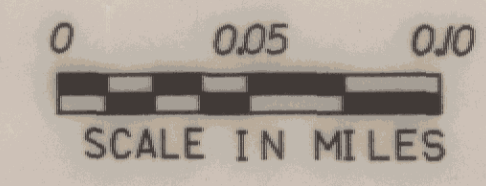

SHOREHAM NEW SIGNS & PAVEMENT MARKINGS

83B030NSI.PRF DATE PLOTTED 29-DEC-1989

SURVEYED BY _____ DATE _____

DRAWN BY J. BULLOCK DATE 3/89

SQUAD LEADER J. PERKINS

DESIGN FILE NO. ZG0450,63183B030.DGN

PROJ. NAME SHOREHAM-BRIDPORT-ADDISON

PROJ. NO. F 017-K(2)

SHEET 198 OF 420 SHEETS

SHEET 198 OF 477