⑩

FINAL SURVEY
NOTE BOOK
No.
SURVEYED
PLOTTED
TEMPLATE
AREAS
AREAS CHECKED
BY
DATE

ORIGINAL SURVEY
NOTE BOOK
No.
SURVEYED
PLOTTED
TEMPLATE
AREAS
AREAS CHECKED
BY
DATE

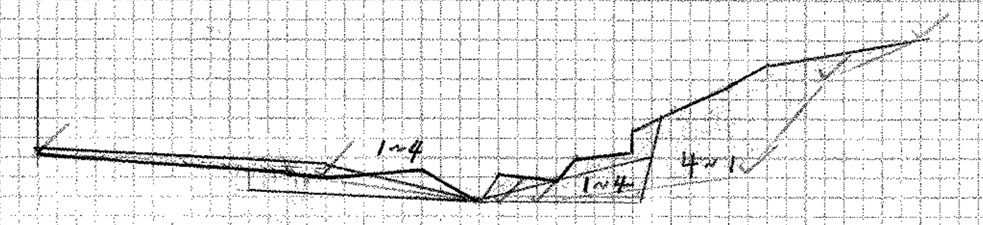

70+75

ROCK

23.0	497.8
31.5	497.8
31.7	498.5
37.0	499.0
41.0	504.0
46.0	506.0
38.0	505.7
31.0	501.5
31.0	500.2
25.0	500.0
27.0	498.9
24.0	499.1
23.0	497.8

R 61.70 W/E

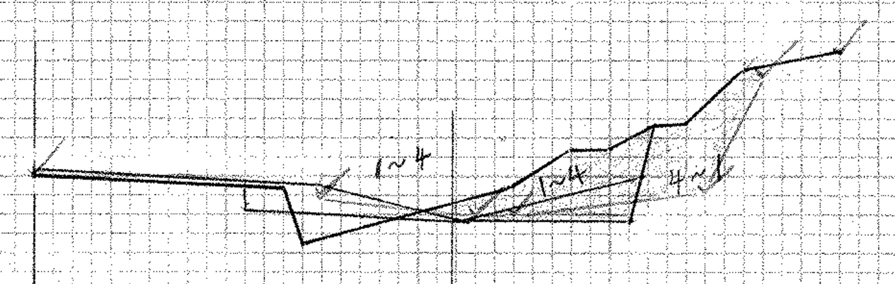

70+50

T.S.G. 21.88

ROCK

21.88	497.8
31.0	497.8
31.3	498.7
35.0	499.4
38.0	505.7
37.0	505.6
34.0	502.8
32.0	502.8
30.0	501.4
28.0	501.4
25.0	499.5
21.88	498.6
21.88	497.8

R 44.9 W/E
46

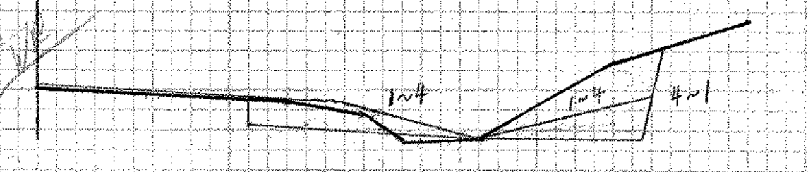

500

70+25

ROCK

23.0	497.7
31.6	497.7
32.4	502.1
30.0	501.4
23.0	497.7

R 22.51 W/E

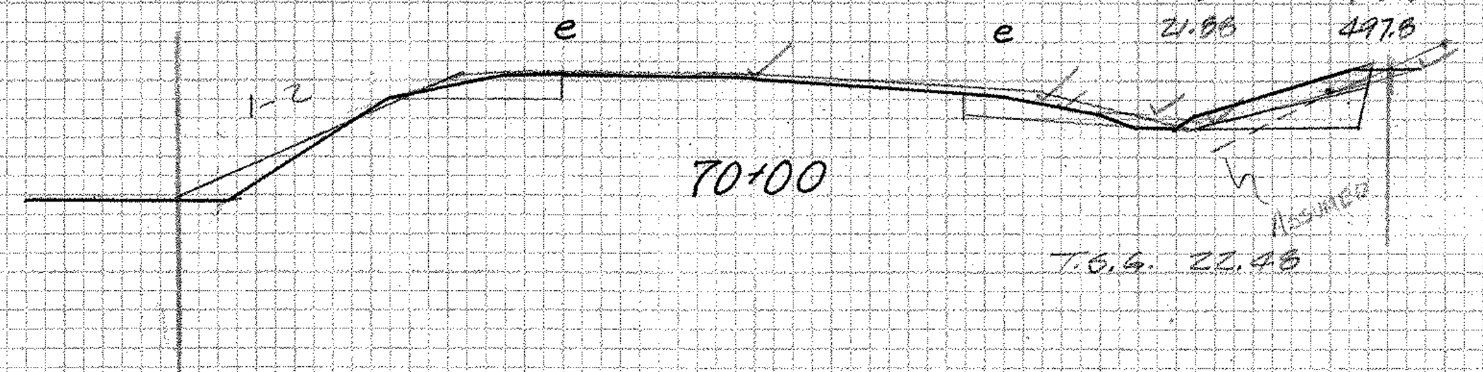

~~500~~

70+00

T.S.G. 22.48

EARTH

23.0	498.0
24.0	497.6
35.0	502.8
31.0	502.8
23.0	498.0

CUT 9.4 W/E

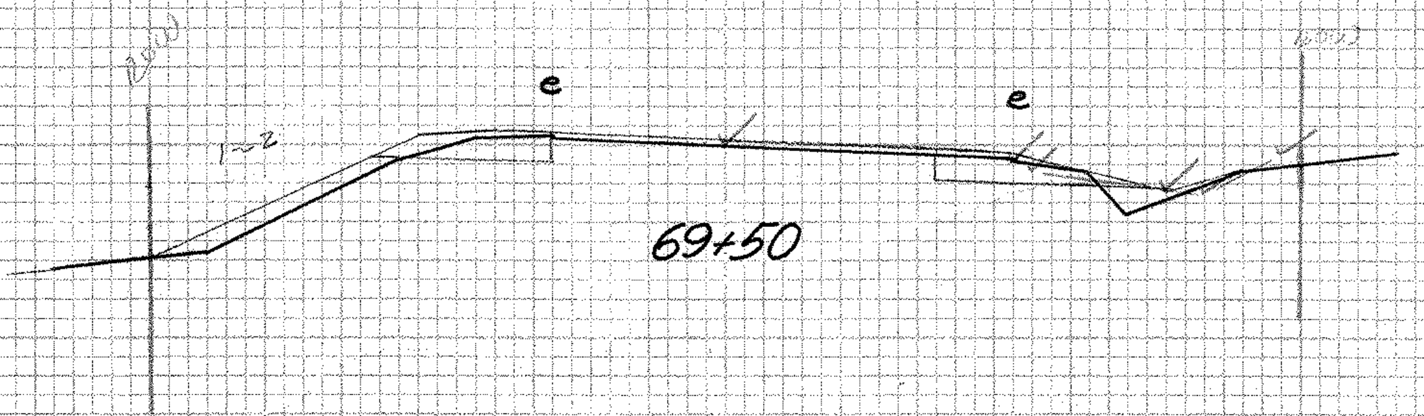

~~500~~

69+50

EARTH

22.20	497.8
23.0	497.8
24.0	497.8
31.5	501.5
30.0	501.2
22.20	498.6
22.20	497.8

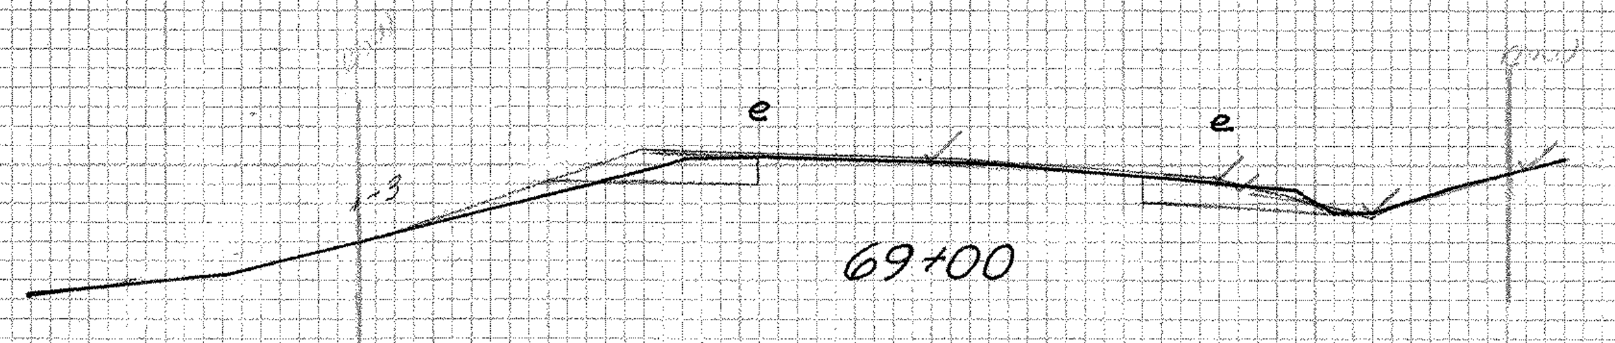

~~500~~

69+00

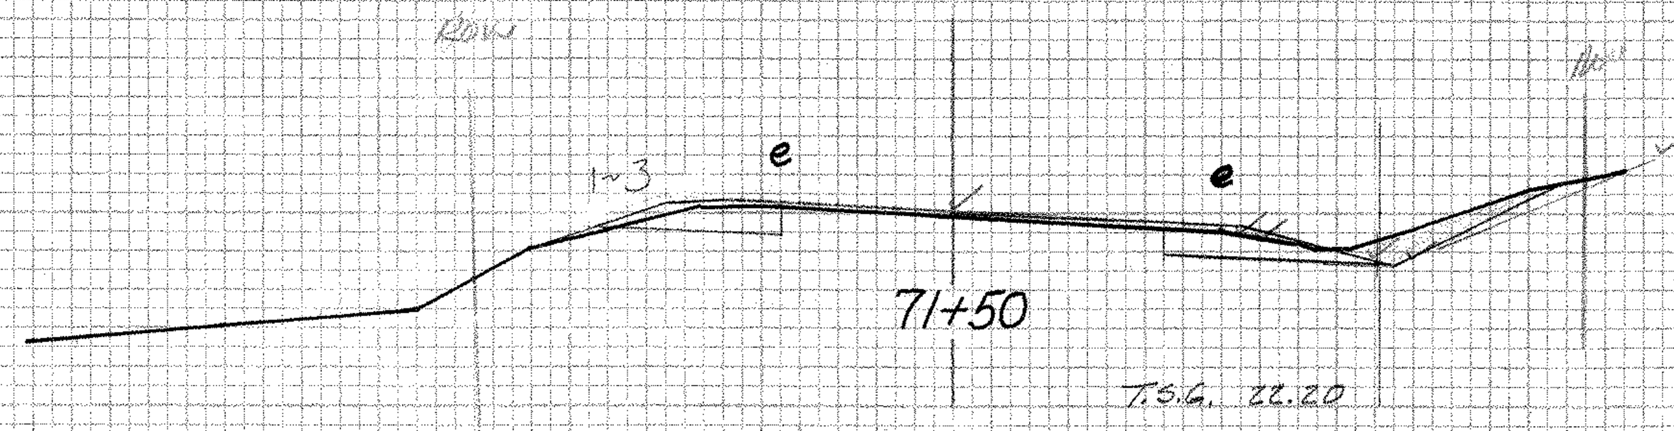

~~500~~

71+50

T.S.G. 22.20

CUT 7.83 W/E

71+45
ZERO LEDGE

ROCK

21.89	497.2
23.0	497.2
31.5	497.2
31.8	498.6
36.0	499.4
40.0	505.8
34.0	502.7
32.0	502.7
30.0	501.5
29.0	499.9
21.51	499.7
21.89	497.2

R 55.42 W/E

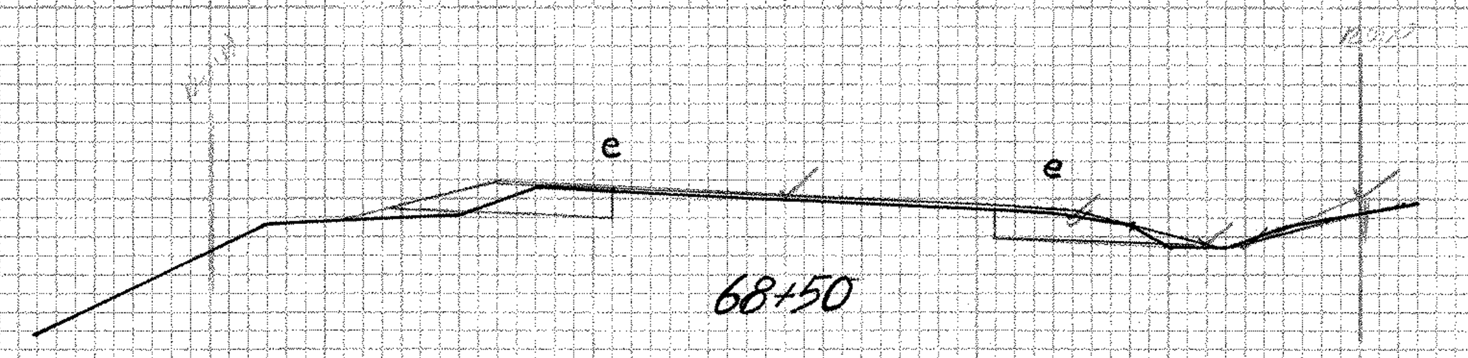

~~500~~

68+50

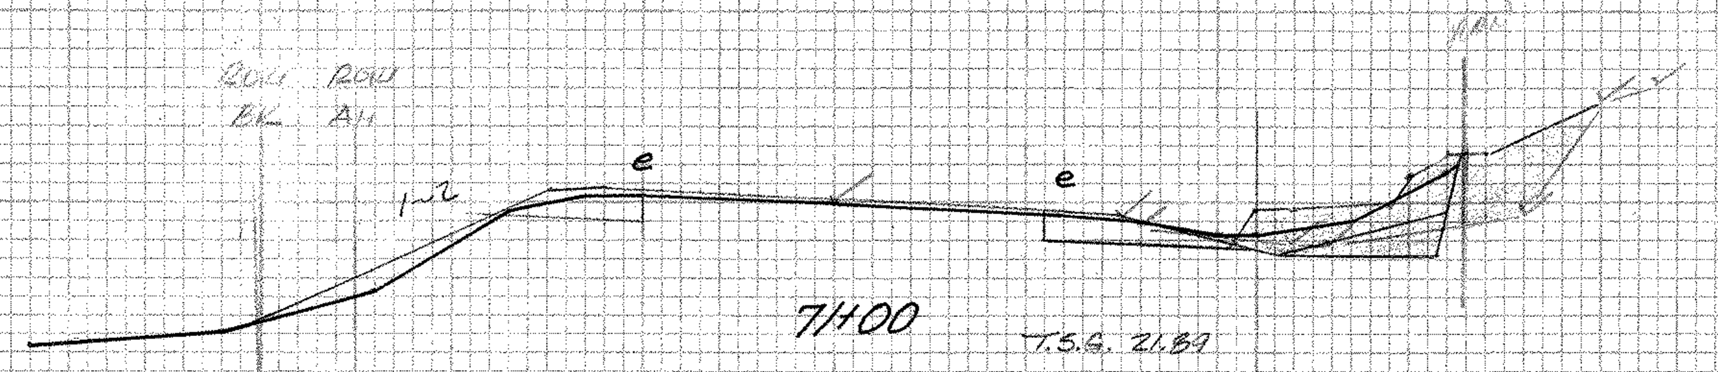

~~500~~

71+00

T.S.G. 21.89

R & EARTHCUT 2-6-92 WJG

LEDGE PLOTTED 12/8/93

SHOREHAM BRIDPORT-ADDISON
F 317-1(2)
68+50 – 71+50

PLATE 3 CROSS SECTION O. P. R. & R. E. STANDARD
DIETZGEN CORPORATION

SHEET 270-B OF 477