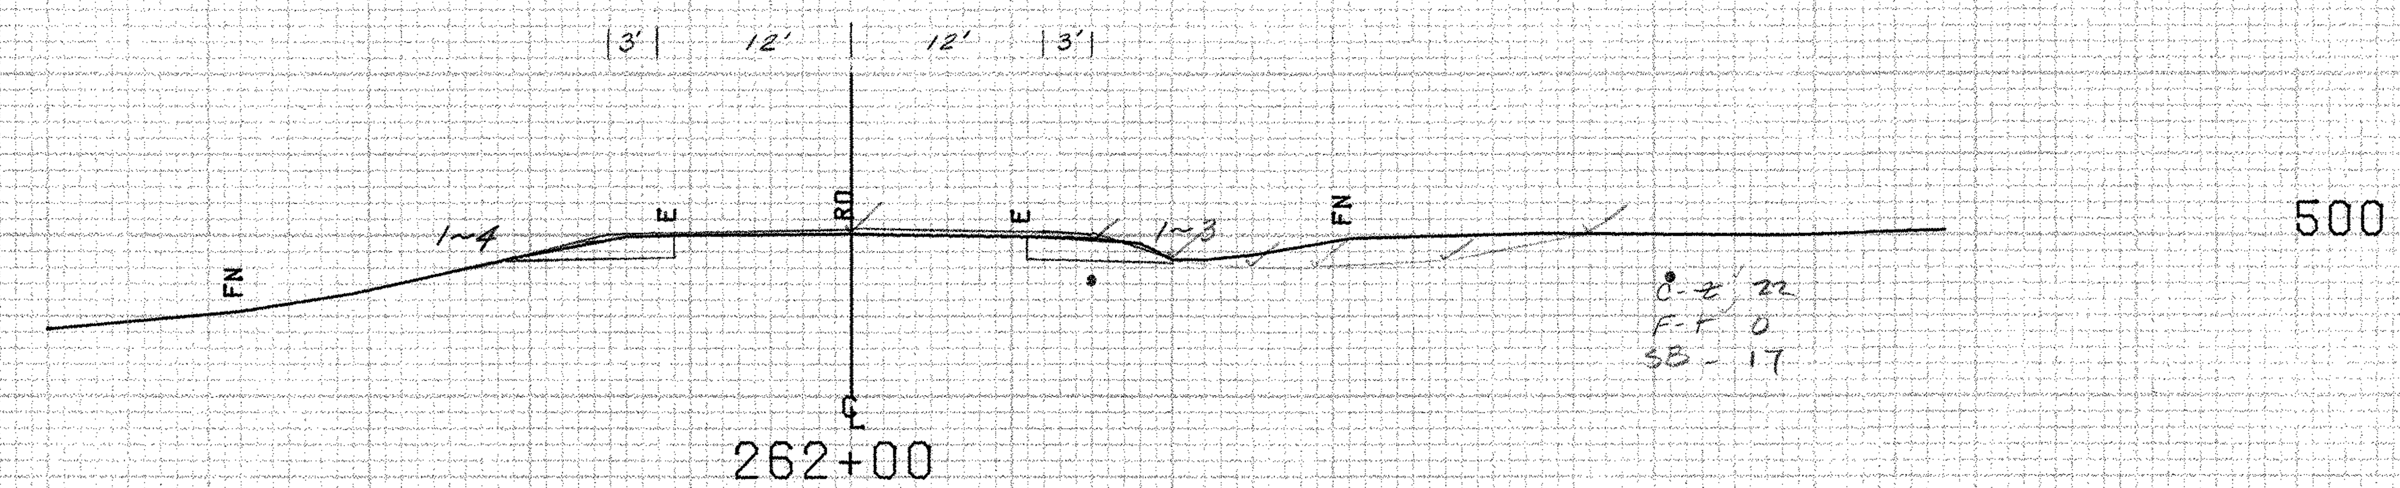

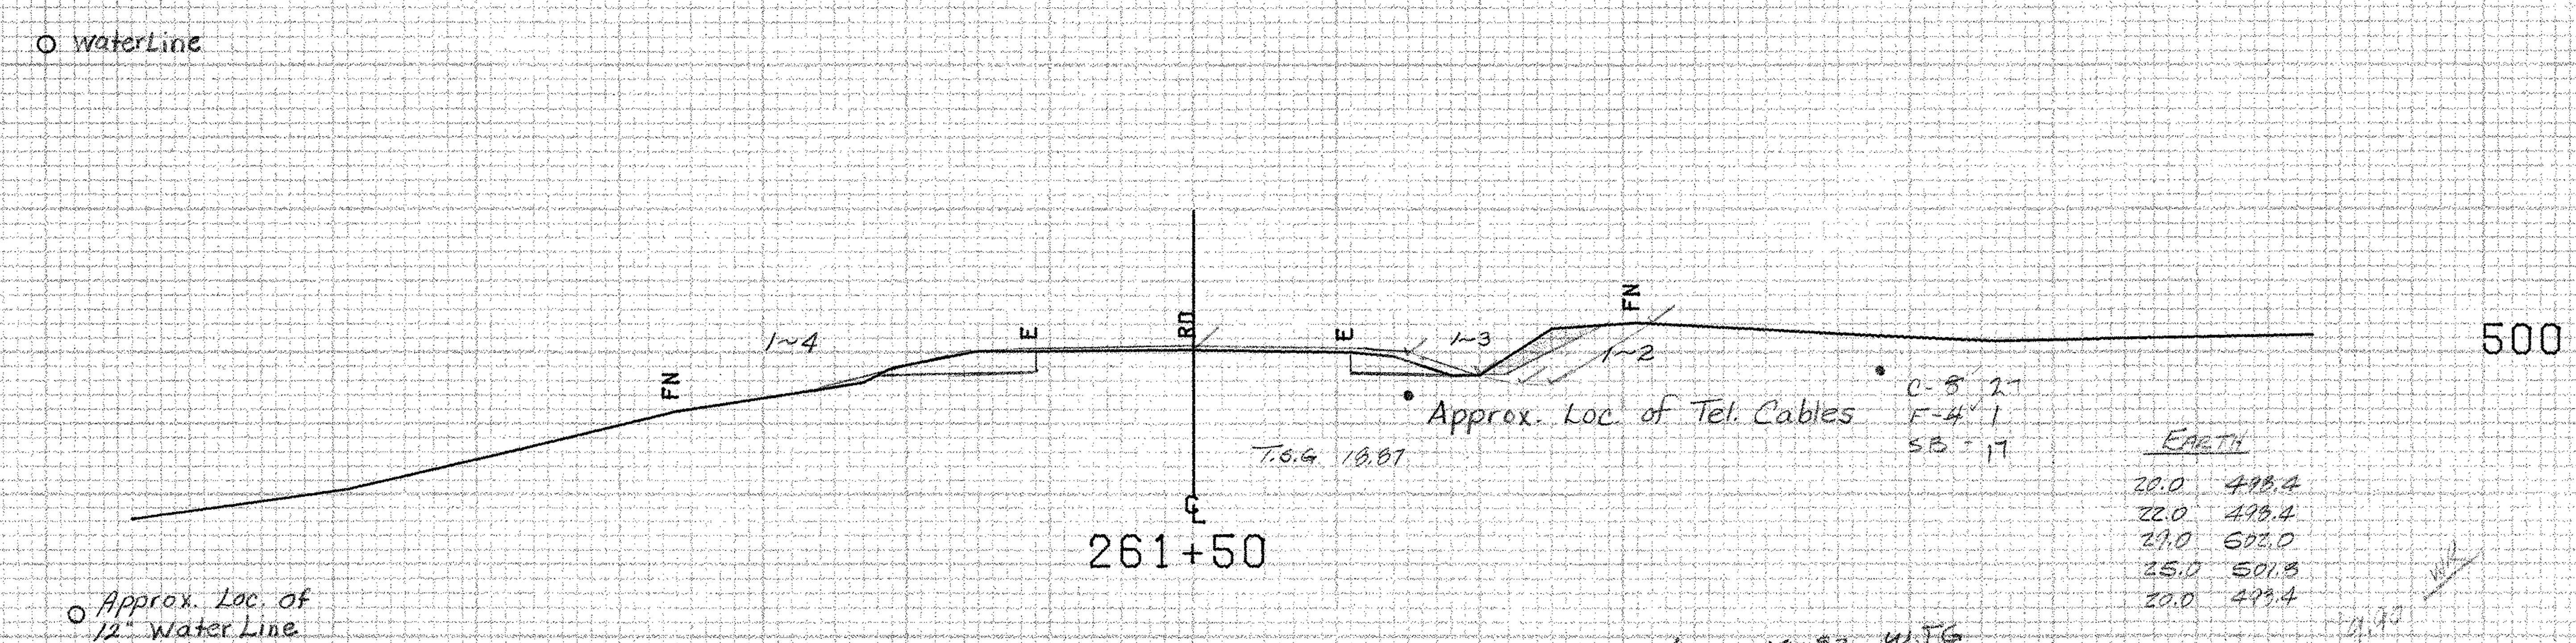

EARTH

20.0	498.4
22.0	498.4
29.0	502.0
25.0	501.8
20.0	498.4

cut 2-10-92 WJG

C 265 F

BRIDPORT MM488 ~ MM 4.96

SCALE 10 FEET

FROM STA. 261+50 TO STA. 262+00
PROJECT NAME SHOREHAM-ADDISON MAIN6
NO. F017-1(2) PLOTTED 01/09/85
SURVEYED BY FANTONI DEC 1984
SHEET 361 OF 420 SHEETS SHEET 361 OF 477