


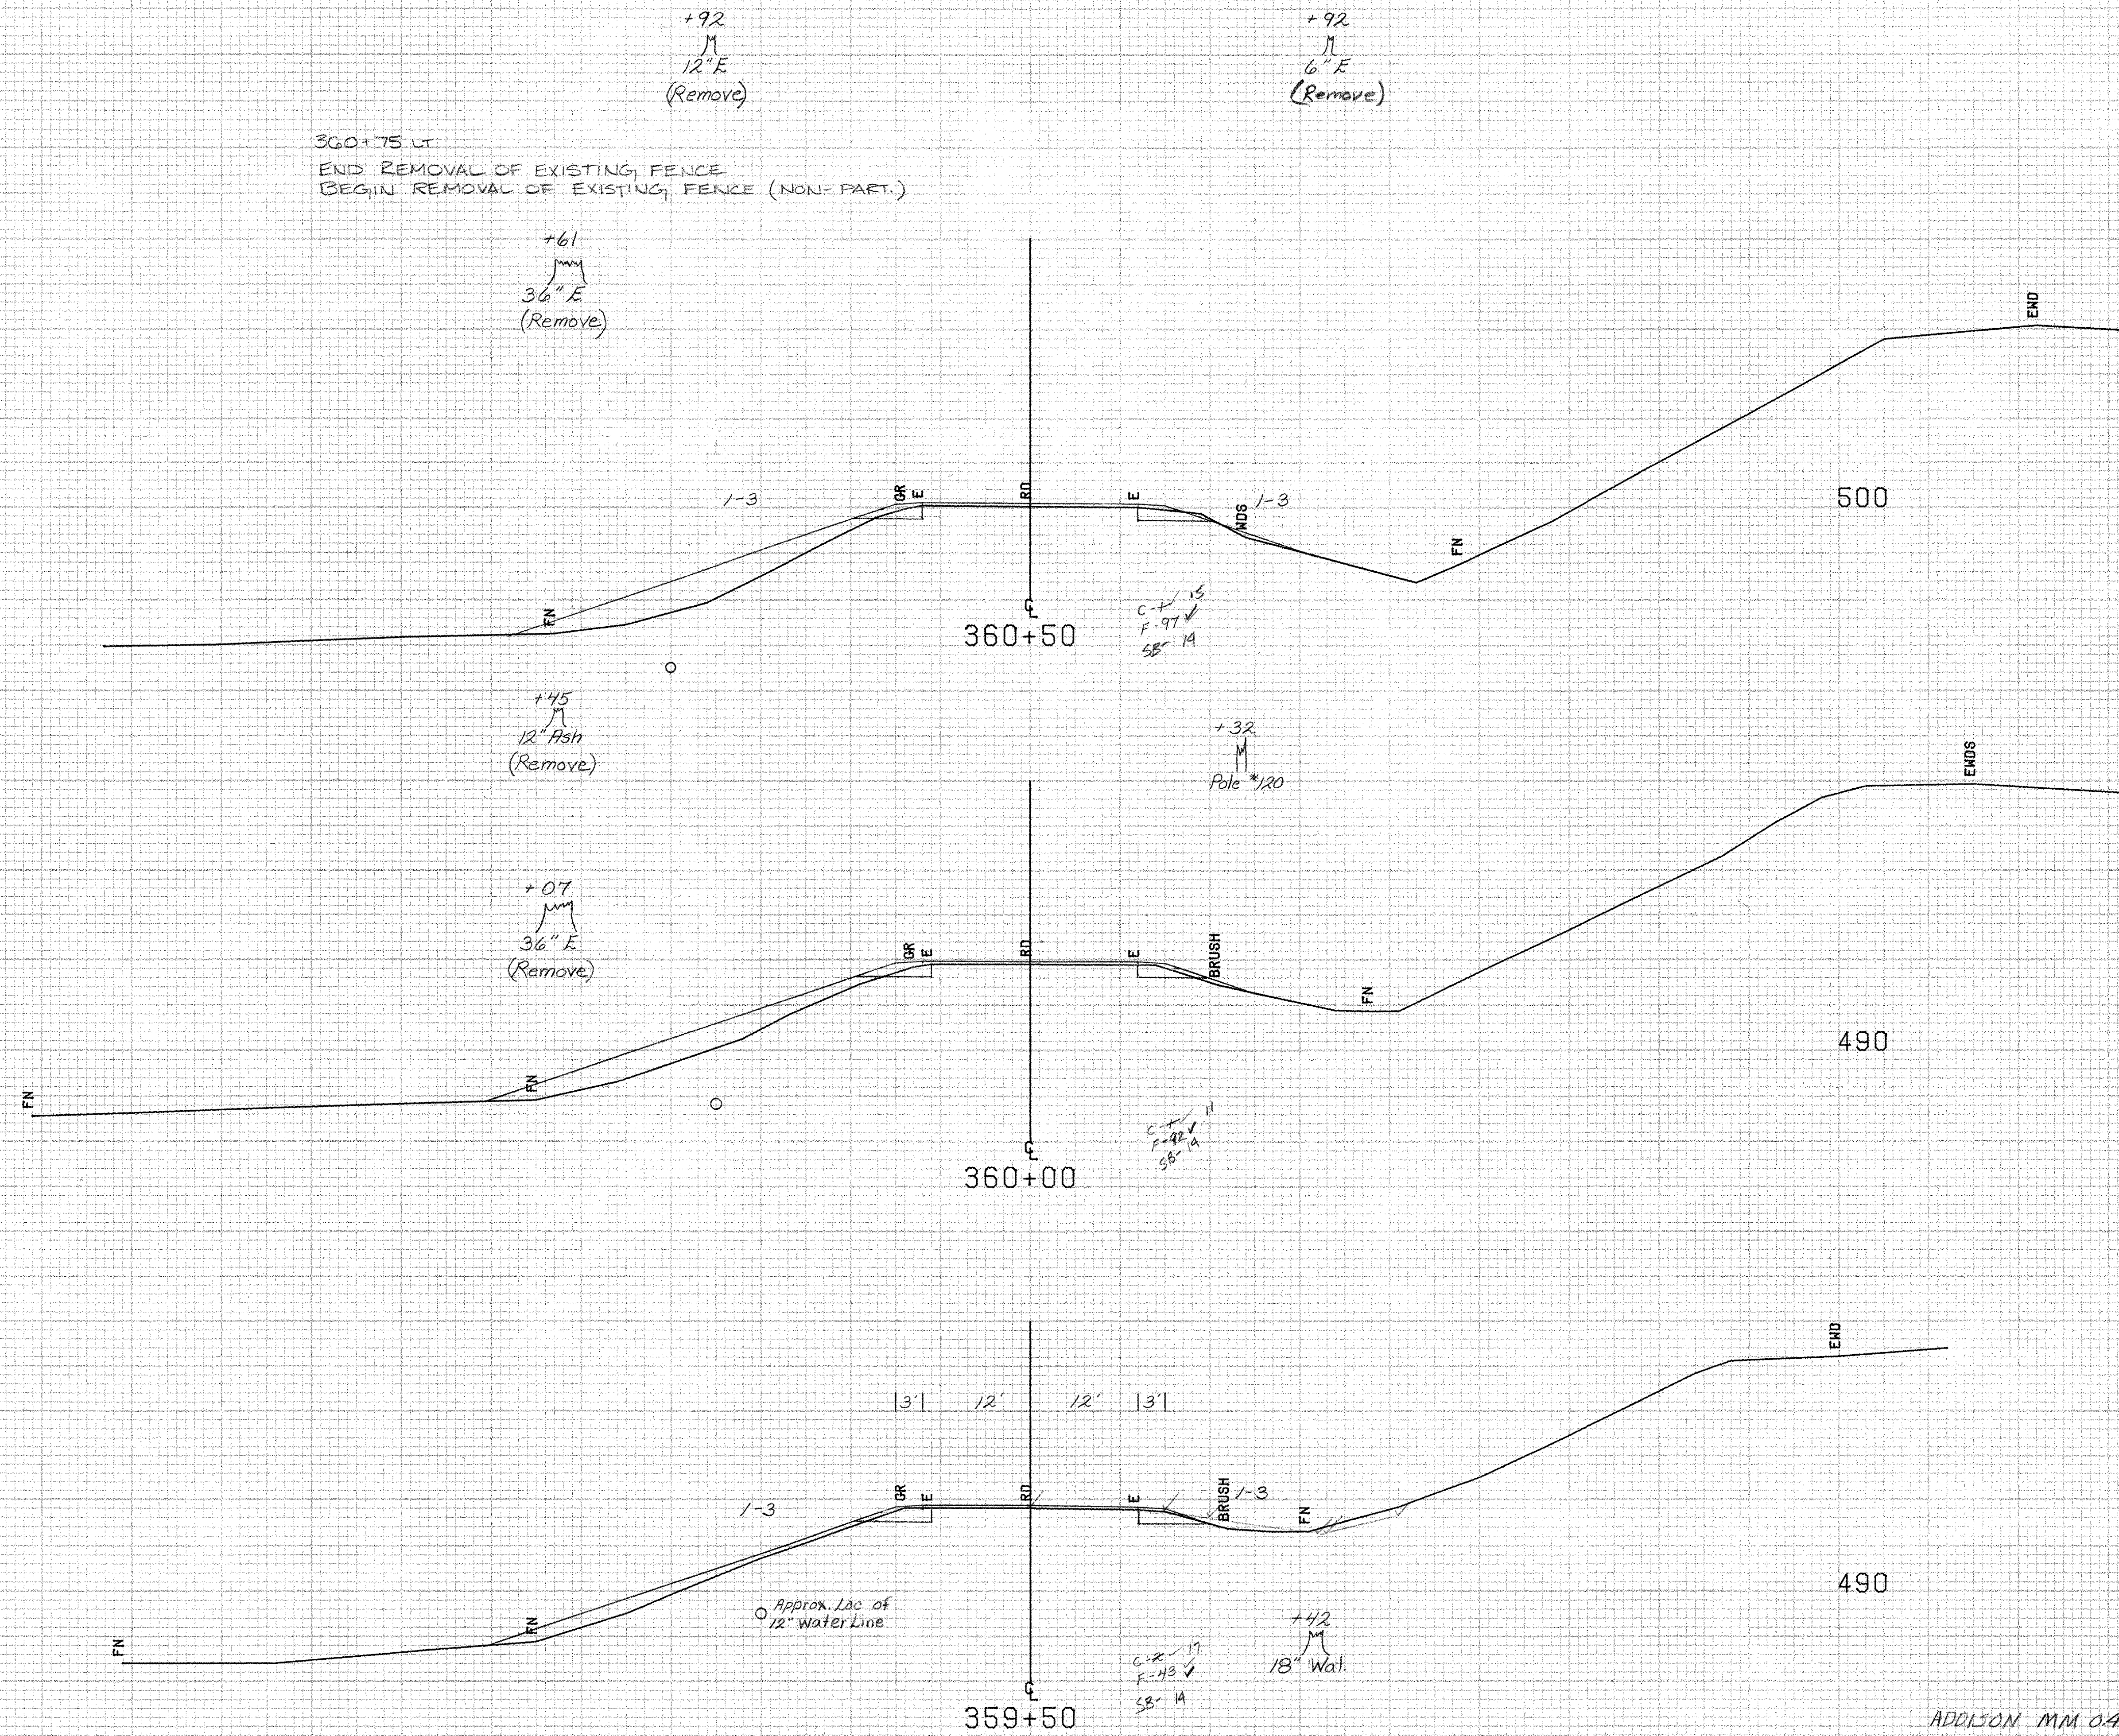

ADDISON MM 0.47 ~ MM 0.56

FROM STA.	359+50	TO STA.	360+50
PROJECT NAME	SHOREHAM-ADDISON	MAIN7	
NO.	F017-1(2)	PLOTTED	01/09/85
SURVEYED BY	FANTONI	DEC	1984
SHEET	392 OF 420 SHEETS	SHEET	392 OF 417

SCALE 10 FEET